

21501112000

I, William C. Jung, do hereby certify that on the 18th day of October 1982, I found (evidence) ~~the evidence~~ of the East 1/4 corner of Section 11, T 15 N, R 1 W Fourth Principal Meridian, and I re-established said corner according to the Wisconsin Statutes as shown and described hereon.

History of corner establishment since Original Government Survey

Holden set an iron bar at this corner in November of 1901.

Description of corner evidence found:

I found Holden's monument at the occupied corner and also one of his bearing trees. The iron was a piece of sleigh shoe. I removed the iron and replaced it with a Harrison marker (bottom broke off, very hard digging).

Dated this 24th day of Jan. 1983.

William C. Jung

Deputy County Surveyor  
Title


COUNTY SURVEYOR FORM NO. 1

Description of corner and witness monuments, references and accessories used to perpetuate the original or re-established location of this corner:

Witnesses to corner location:

Jung

Pliner

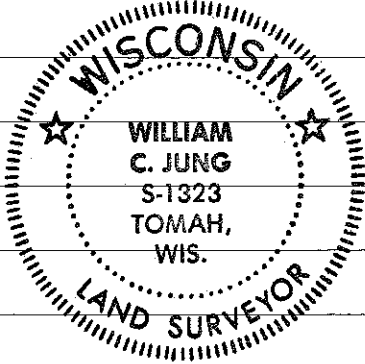

Approved: **HARLEY A. SIME**  
**MONROE CO. SURVEYOR**  
SURVEY CONTROL ORDER

Dist. to nail in hack on double blazed 18" Oak

Dist. to nail in hack on double blazed 11" Maple

Found piece of sleigh shoe buried by old fence post. Removed and set Harrison by steel fence post. (Broke off bottom of H.M.)

Dist. to nail in hack of single blazed 34" Oak (Holden's old tree)

Dist. to nail in hack on double blazed 33" Oak

Horizontal \_\_\_\_\_  
Vertical \_\_\_\_\_

WISCONSIN COORDINATE SYSTEM

Corner	East (X)	North (Y)	Elevation (Z)	Zone
Control Sta. Name				

~~City, Village or~~ Town of Wellington  
County of Monroe

