

21501140000

I, William C. Jung, do hereby certify that on the 11th day of October, 1982, I found (evidence) ~~of the~~ of the Northwest corner of Section 24, T 15 N, R 1 W Fourth Principal Meridian, and I re-established said corner according to the Wisconsin Statutes as shown and described hereon.

History of corner establishment since Original Government Survey

LaRue found this corner in April of 1900. In his notes of June, 1910, Holden shows a stone at this corner which was set at the original corner location.

Description of corner evidence found:

Dated this 7th day of Feb. 1983.

(See attached sheet, page2)

William C. Jung
Deputy County Surveyor
Title

**Approved: HARLEY A. SIME
MONROE CO. SURVEYOR**




COUNTY SURVEYOR FORM NO. 1

Description of corner and witness monuments, references and accessories used to perpetuate the original or re-established location of this corner:

Witnesses to corner location:

Jung

Pliner

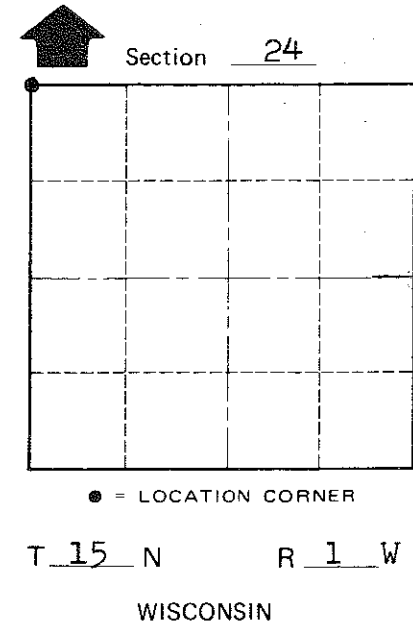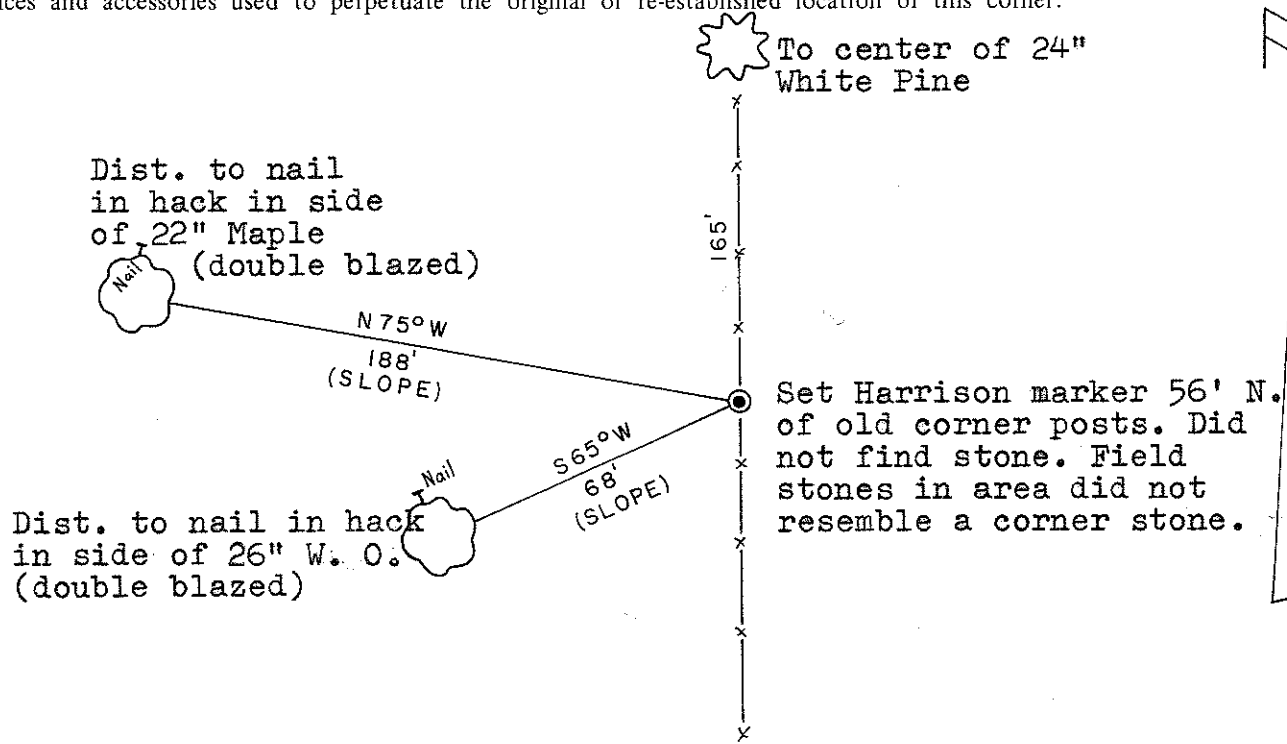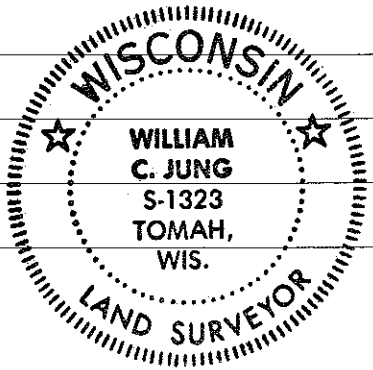

SURVEY CONTROL ORDER

Horizontal	_____
Vertical	_____

WISCONSIN COORDINATE SYSTEM

Corner	East (X)	North (Y)	Elevation (Z)	Zone
Control Sta. Name				

~~City, Village or~~ Town of Wellington
County of Monroe

Northwest Corner-Section 24-T15N-R1W

Pliner and I searched extensively for the stone of record but found nothing. Meyer and I had also searched twice earlier. Don Kreiger said that his father told him that the stone was by the old corner posts 56' South of our final corner location. Pliner, Kreiger, and I dug for the stone in and around the corner posts but found nothing. After analyzing all the field evidence in all (4) cardinal directions, I reset the corner at a computed location. As set, my distance back to the South 1/4 Corner of Section 14 matches Holden's distance within about 0.53'. To the South, the old fence corner at the W1/16NW of Section 24 fits the computed final location almost exactly in relation to the final 1/2 mile. This final 1/2 mile distance is 7.35' short of Holden's, which isn't bad considering the terrain. The 1/2 mile North from my final corner at the NW of Section 24 is long, but the final true W1/16SW of Section 13 fits the existing conditions very well. The latter "forty" corner is on line with the old line fence to the South and 3.8'± North of the occupied corner (NW corner of a school parcel as deeded in Volume 39 Deeds, Page 79, in 1878). It appears that the West line of the SW1/4 of Section 13 is supposed to be long. These conditions are typical of the problems and irregularities found in the Town of Wellington. I feel that the location of my final section corner is in the most logical location.

