

21501210000

I, William C. Jung, do hereby certify that on the 7th day of April 1983, I found (evidence) ~~(no evidence)~~ of the Northeast corner of Section 28, T 15 N, R 1 W Fourth Principal Meridian, and I re-established said corner according to the Wisconsin Statutes as shown and described hereon.

Dated this 21st day of Dec. 1983.

William C. Jung
Deputy County Surveyor, R.L.S. 1323
Title

History of corner establishment since Original Government Survey

Fred Holden re-established this corner in November and December of 1901. He again used this corner in November of 1905 and May of 1906. A.S. Ingalls was at this corner in March of 1873.

Description of corner evidence found:




This corner was set at a computed location by intersecting the occupied North line of the NW1/4-NEL/4 with the occupied East line of the NE1/4. In my opinion this location best fits the evidence found in the NE1/4 of Section 28. After a great deal of searching, I could not find any other evidence of any previous corner.

Description of corner and witness monuments, references and accessories used to perpetuate the original or re-established location of this corner:

Witnesses to corner location:

William C. Jung

Dallas Wilhite

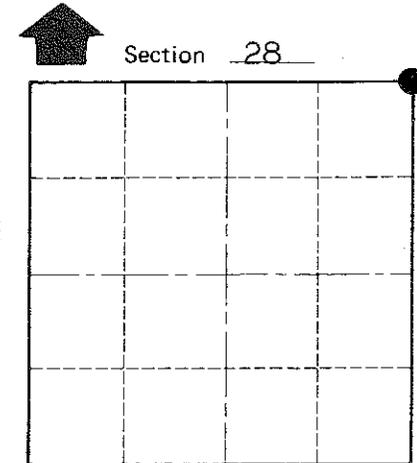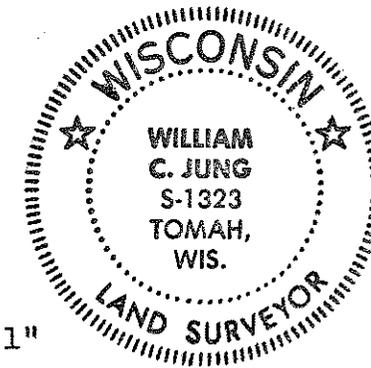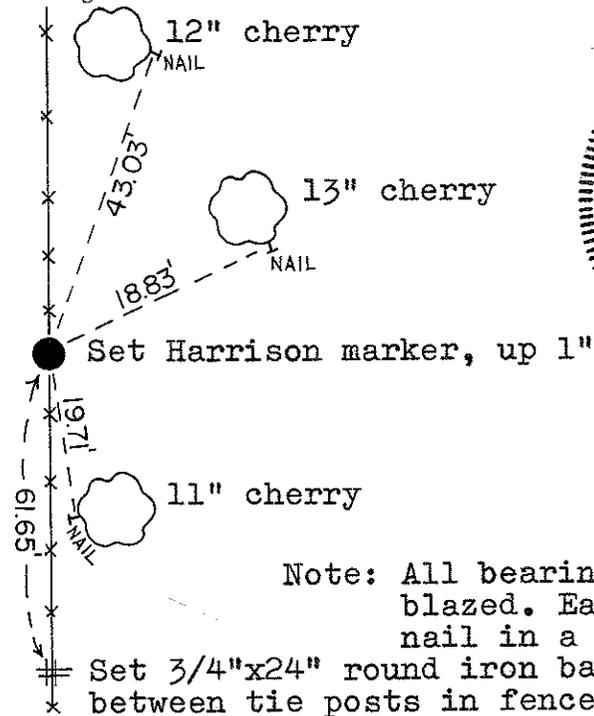

• = LOCATION CORNER

Approved: **HARLEY A. SIME**
MONROE CO. SURVEYOR

Note: All bearing trees are double blazed. Each distance is to a nail in a hack on the side of the tree.

SURVEY CONTROL ORDER

Horizontal _____
Vertical _____

WISCONSIN COORDINATE SYSTEM

Corner	East (X)	North (Y)	Elevation (Z)	Zone
Control Sta. Name				

City, Village or Town of Wellington
County of Monroe
Wisconsin

COUNTY SURVEYOR FORM NO. 1