

CERTIFICATE

CERTIFIED LAND CORNER

No. 107

21501280000

I, William C. Jung, do hereby certify that on the 19th day of September 1978, I found (evidence) (no evidence) of the NW corner of Section 34, T 15 N, R 1 W, Fourth Principal Meridian, and I re-established said corner according to the Wisconsin Statutes as shown and described hereon.

Dated this 5th day of Jan. 1979.

William C. Jung, R.L.S. 1323

Crew Chief, County Surveyor's Title Office

History of original corner establishment:

Fred Holden was at this corner in Nov. and Dec. of 1901 and in May of 1906.

Description of corner evidence found:

Found Marten's iron bar and replaced it with a Harrison. Marten the occupied fence corner as the best available evidence of the original corner.

Description of corner and witness monuments, references and accessories used to perpetuate the original or re-established location of this corner:

Set Harrison in place of iron bar, up 4", on west side of fence post. Set rocks around Harrison.



Witnesses to corner location:

W. Jung

R. Lamb



(All trees are double blazed with N&C's set)

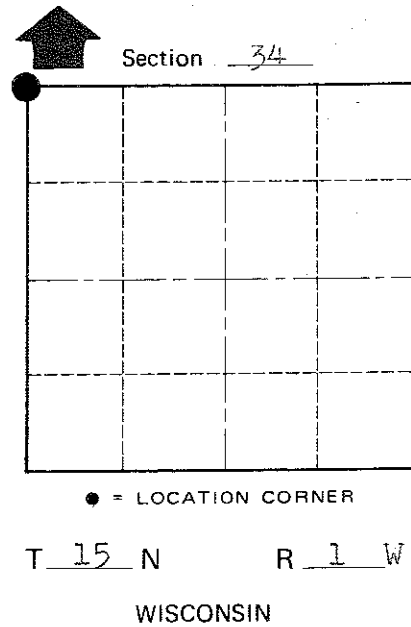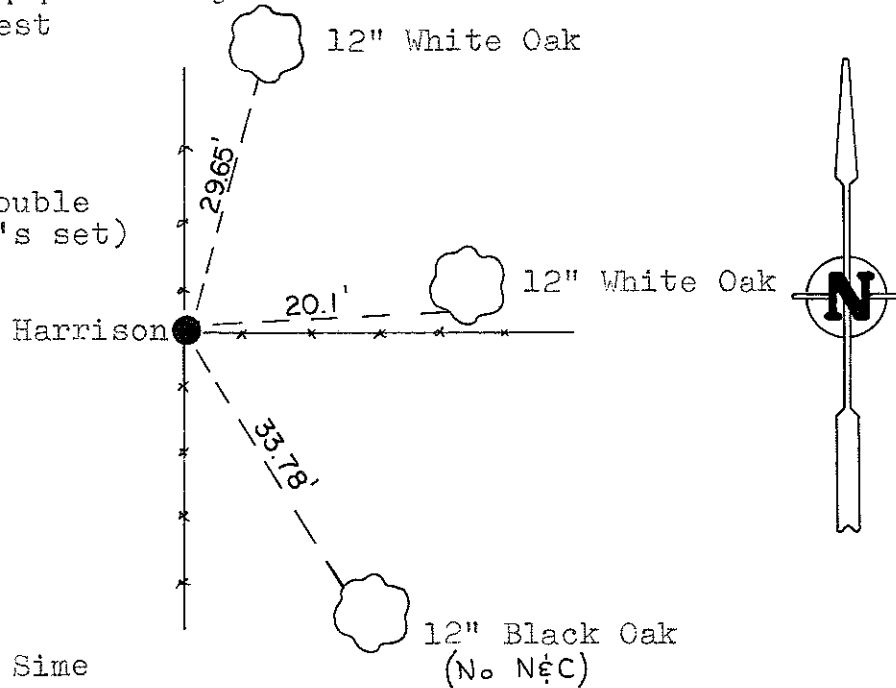

COUNTY SURVEYOR FORM NO. 1

SURVEY CONTROL ORDER

Table with 2 rows: Horizontal, Vertical.

Approved by: Harley A. Sime, County Surveyor

WISCONSIN COORDINATE SYSTEM

Table with 5 columns: Corner, East (X), North (Y), Elevation (Z), Zone. Includes a row for Control Sta. Name.

City, Village or Town Wellington, County of Monroe