

21501290000

I, William C. Jung, do hereby certify that on the 12th day of April 1983, I found (evidence) ~~(no evidence)~~ of the Southwest corner of Section 28, T 15 N, R 1 W Fourth Principal Meridian, and I re-established said corner according to the Wisconsin Statutes as shown and described hereon.

Dated this 29th day of Feb. 1984.

William C. Jung

Deputy County Surveyor, R.L.S. 1323
Title

History of corner establishment since Original Government Survey

Kenyon (or Schroeder?) was at this corner in October of 1890 and December of 1891. In May of 1906 Fred Holden shows that he found the original corner.

Description of corner evidence found:


I set the corner at a distance of approximately 2656'+ South of the Harrison marker at the West 1/4 Corner. I searched the area extensively for old bearing trees and other evidence but found none. About N53°E, 15' from my corner I found a 20" black oak stump. The original notes called for a 18" white oak, N52°E, 18.48'. I also dug at the occupied corner but found nothing. The 1891 notes call for a distance of 2656.5 feet along the West line of the SW1/4, and the corner being 34.32' South of a cross on a rock. My corner is now 34' South of the rock face, and my 1/2 mile fits the 1891 distance. The 1890 distance was about 2659', a slight difference in distance. I could not find the cross. I feel that it has eroded away. (continued on back)

Description of corner and witness monuments, references and accessories used to perpetuate the original or re-established location of this corner:

Witnesses to corner location:

William Jung

Bryan Meyer


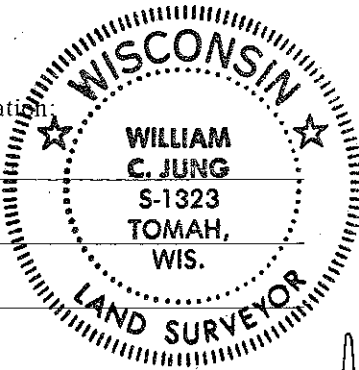


COUNTY SURVEYOR FORM NO. 1

Approved: **HARLEY A. SIME**
MONROE CO. SURVEYOR

SURVEY CONTROL ORDER

Horizontal _____
Vertical _____

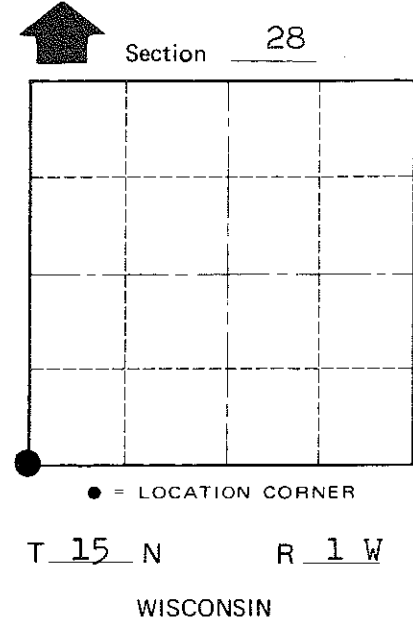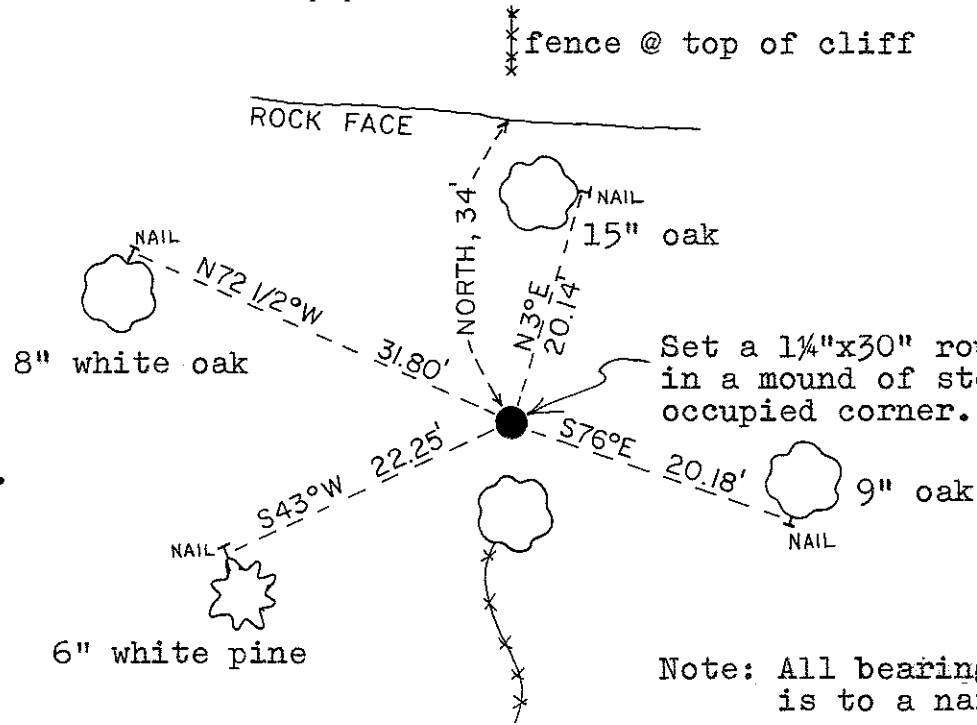

Note: All bearing trees are double blazed. Each distance is to a nail in a hack on the side of the tree.

WISCONSIN COORDINATE SYSTEM

Corner	East (X)	North (Y)	Elevation (Z)	Zone
Control Sta. Name				

City, Village or Town of Wellington
County of Monroe
Wisconsin

(continued)

The surveys in 1890 and 1891 obviously differed from Holden's 1906 survey. Holden's corner was S21°W, 25.74 feet from the cross on the sandstone ledge. The corner is on line with an old straight fence to the North. It also lines up with the remains of a fence to the West. The meandering fence to the South stops at this point, and the fence going North-South at this point changes from woven to strand. Further to the East I found a fence to the East of the ridge. I pushed the fence West at a magnetic azimuth of 267° and hit my accepted occupied corner. I feel that my location fits the 1890-1891 surveys. Why those old surveys differed with Holden I don't know. This wouldn't be the first time that I've run into this problem. I might add that my corner location is just about on line with the SE and S1/4 Corners of Section 28.