


Sheldon PLSS Corner Coordinates - SE

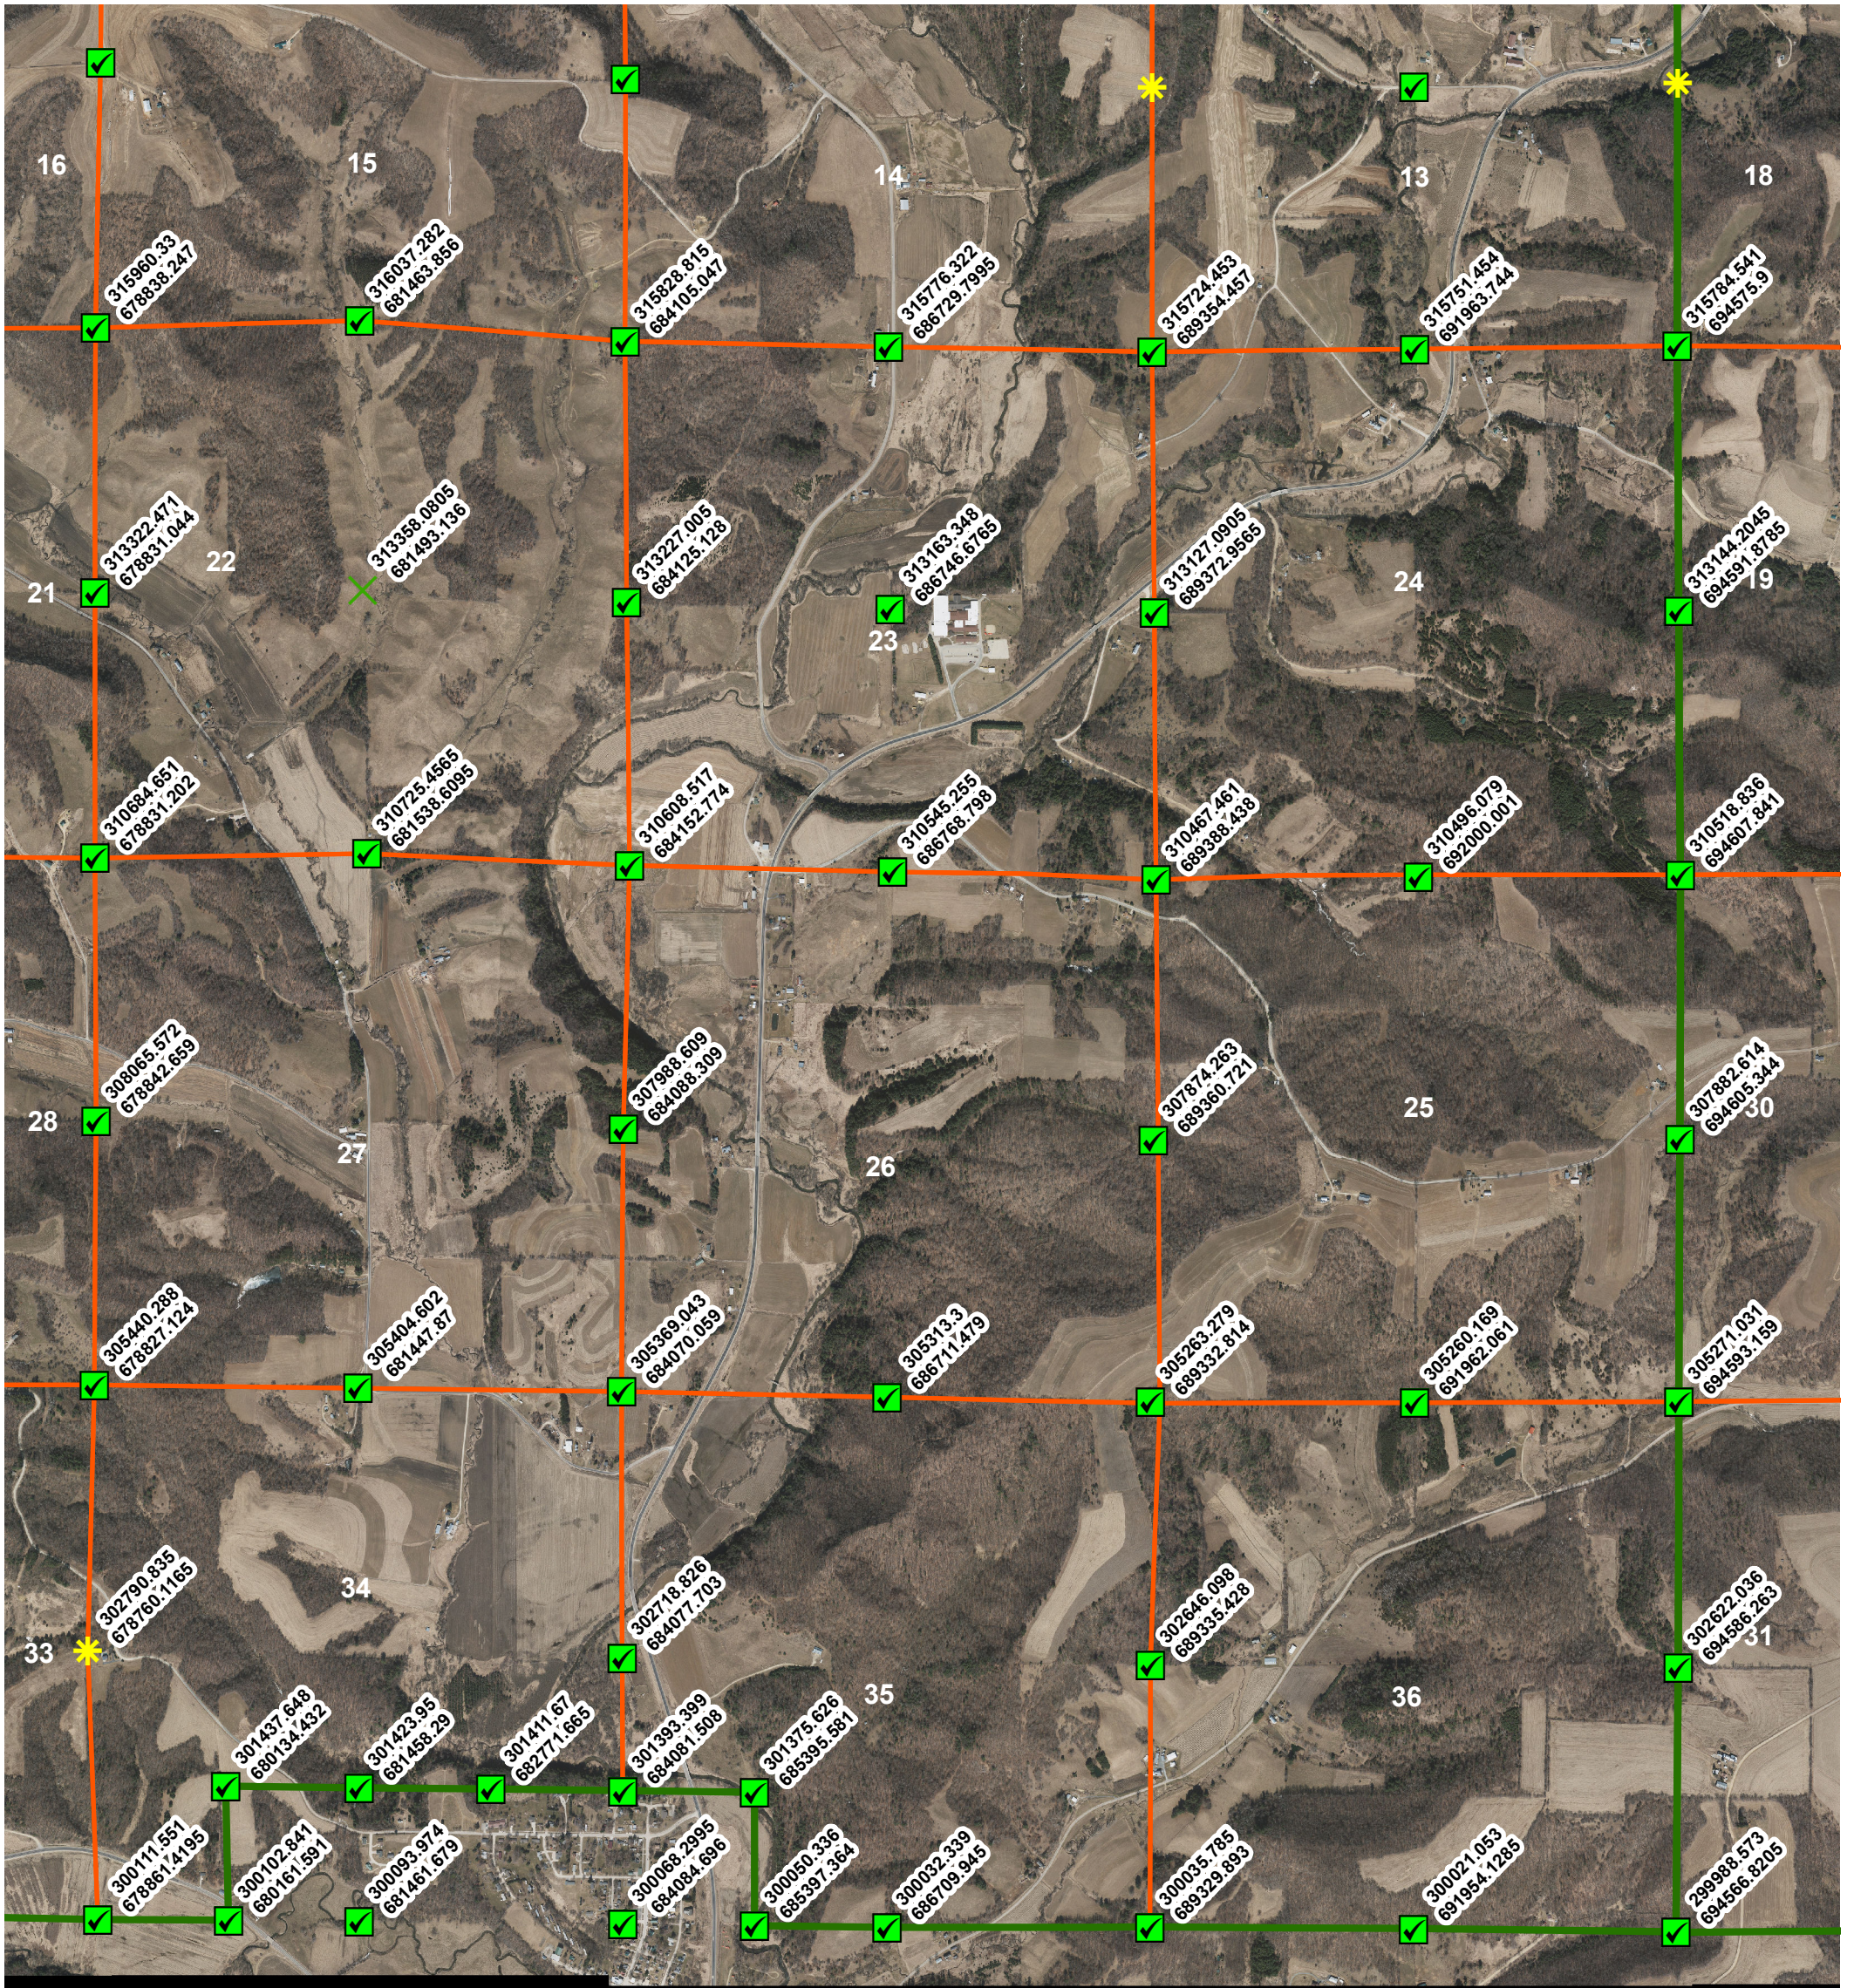

Legend

PLSS Coordinates Coordinate Method

- ✱ Derived
- ✔ GPS
- ✕ Survey