


Sheldon PLSS Corner Coordinates - SW

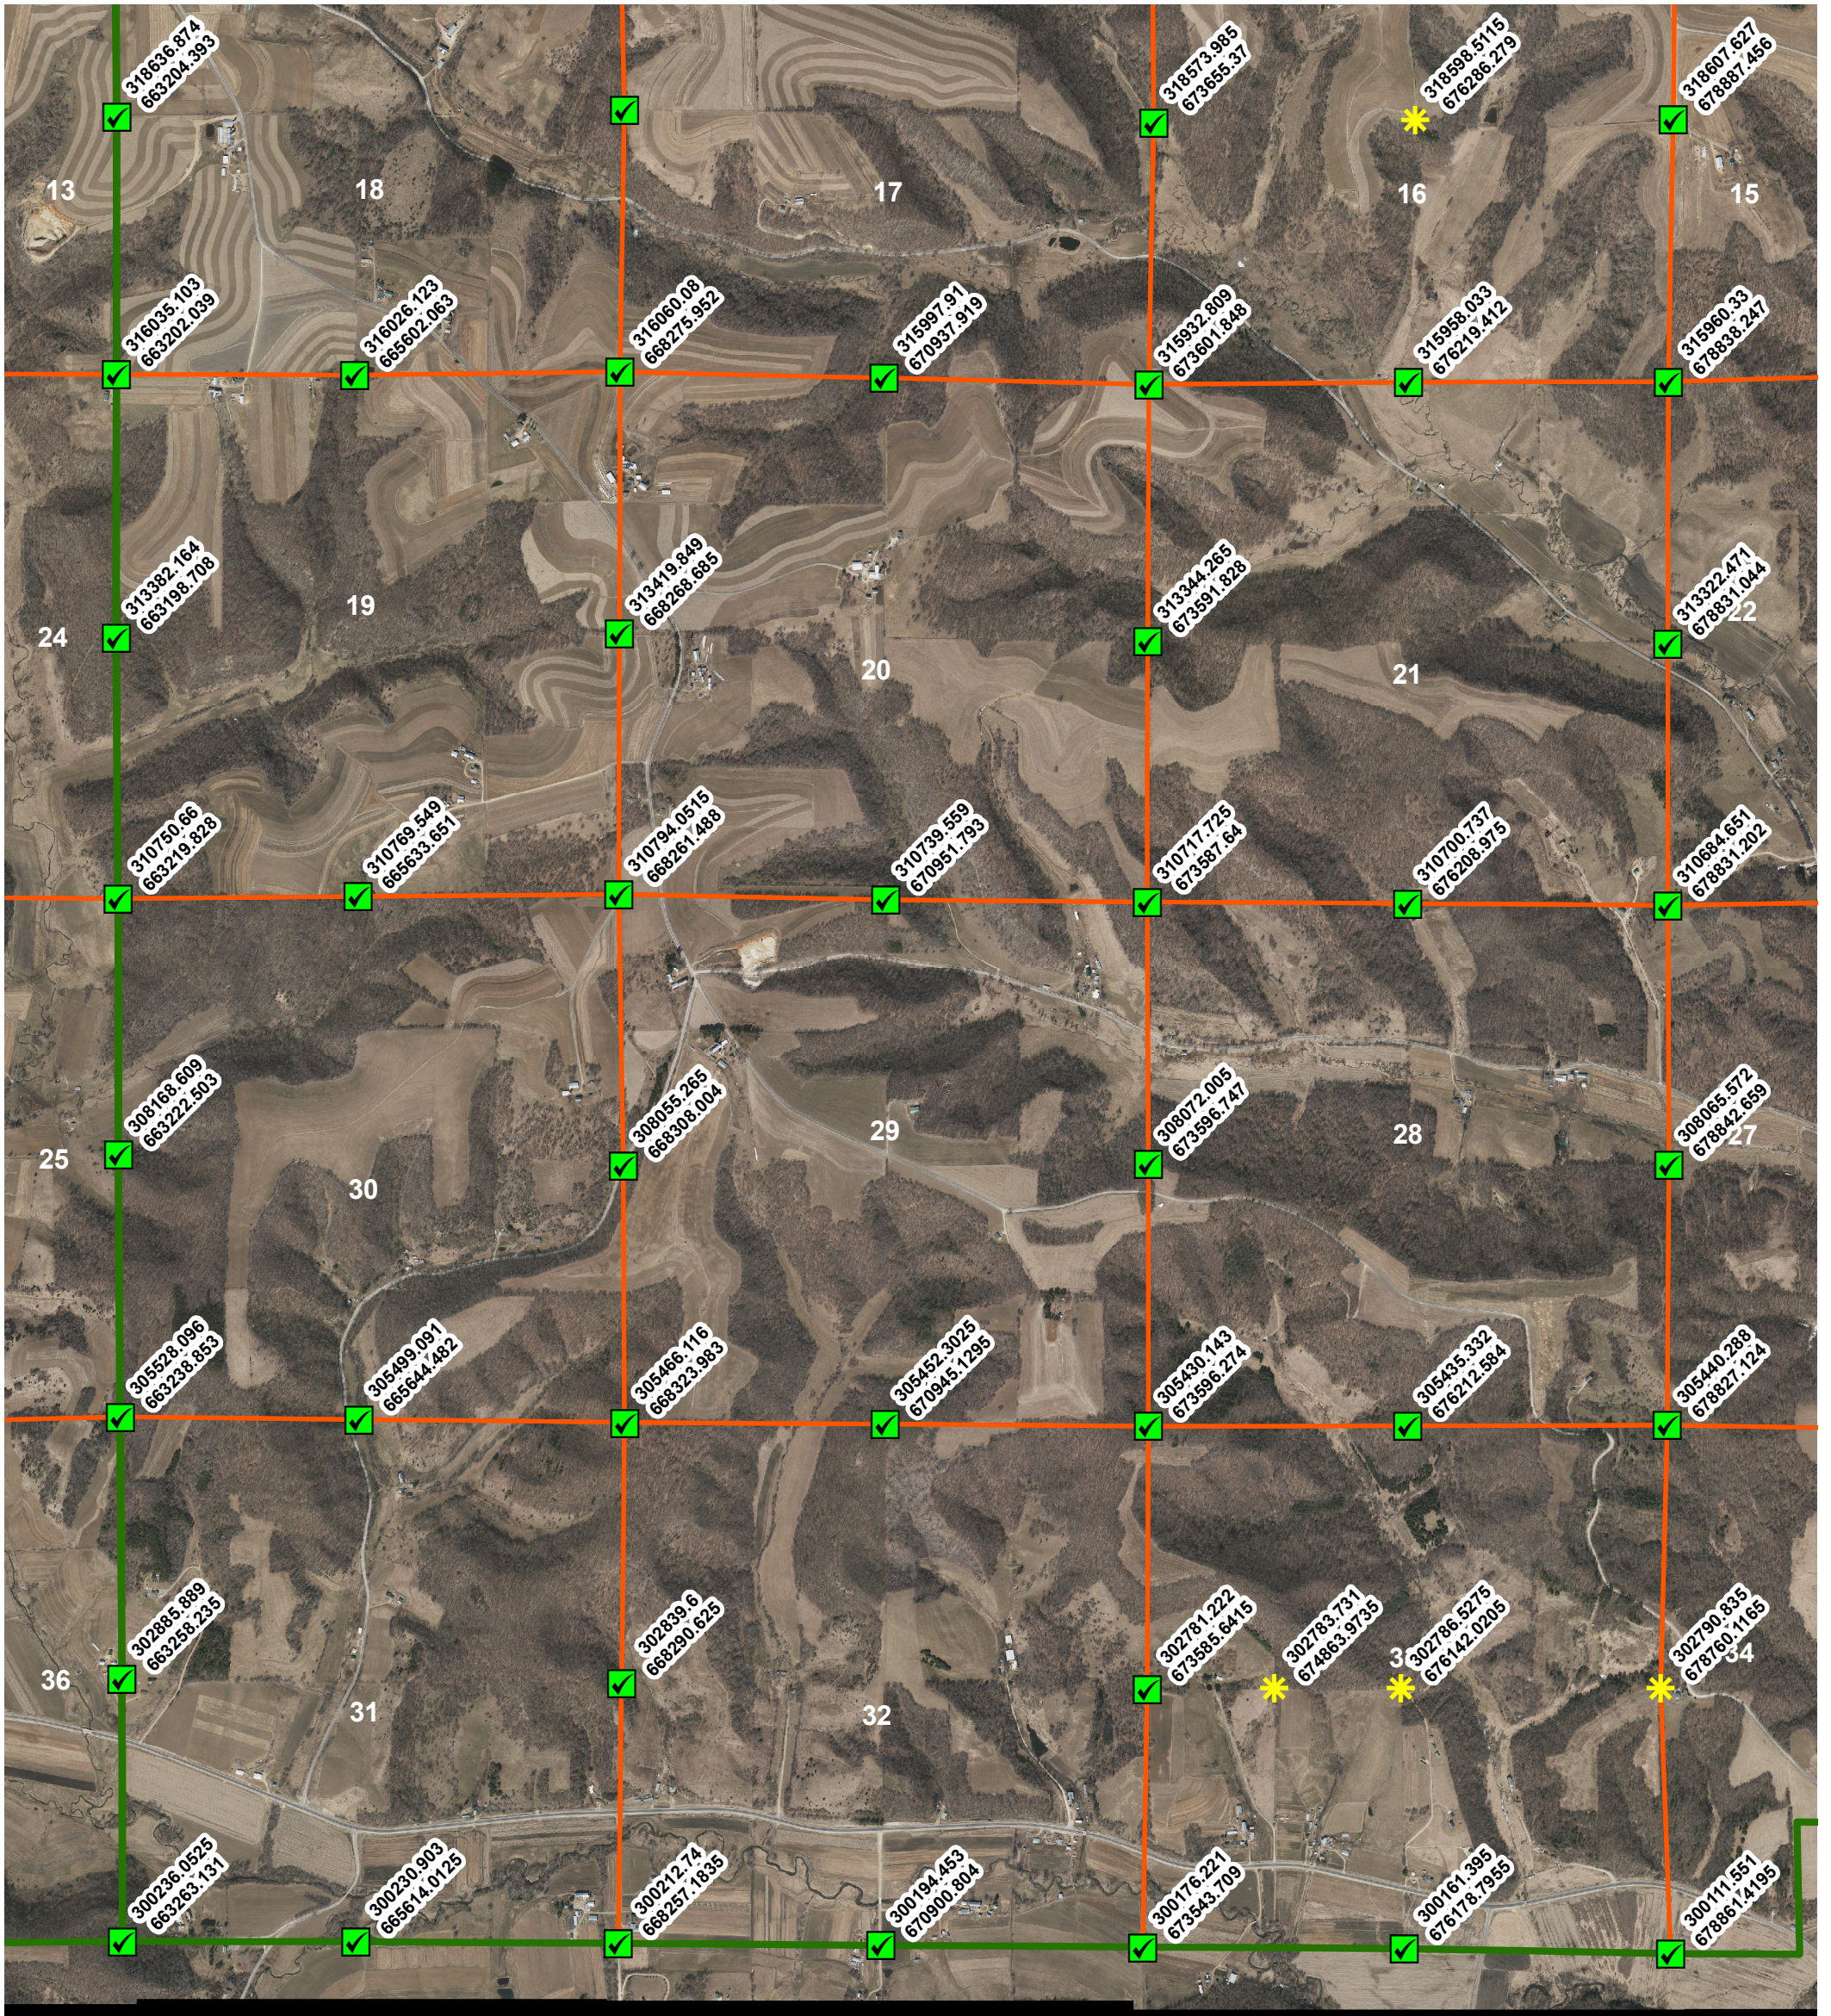

Legend

PLSS Coordinates

Coordinate Method

- * Derived
- ✓ GPS