CERTIFICATE

I, William C. Jung, do hereby certify that on the 19th day of April 19 84, I found (evidence) ~~(no evidence)~~ of the West 1/4 corner of Section 31, T 15 N, R 2 W Fourth Principal Meridian, and I re-established said corner according to the Wisconsin Statutes as shown and described hereon.

Dated this 8th day of May 19 84.

William C. Jung

Deputy County Surveyor, R.L.S. 1323

Title

CERTIFIED LAND CORNER

No. 114

21503362000

History of corner establishment since Original Government Survey

The Monroe County records show that a surveyor was at this corner in March of 1898 and set a post at an old corner location. Schroeder and/or LaRue were at this corner in November and December of 1899 and found the corner to be in. Fred Holden shows this corner on his Plat of Home Cemetery in April of 1934.

Description of corner evidence found:

This corner falls in an old cemetery and was set so as to best fit the old accepted occupation, cemetery deeds, and the old cemetery plat. While setting the Harrison, I also dug a trench, but found no evidence of the old corner. Mr. Currier, the old caretaker, was a witness.

COUNTY SURVEYOR FORM NO. 1

Description of corner and witness monuments, references and accessories used to perpetuate the original or re-established location of this corner:

Witnesses to corner location:

William C. Jung

Mr. Currier (the old caretaker)

Approved: Harley Sime
County Surveyor

WISCONSIN
WILLIAM C. JUNG
S-1323
TOMAH, WIS.
LAND SURVEYOR

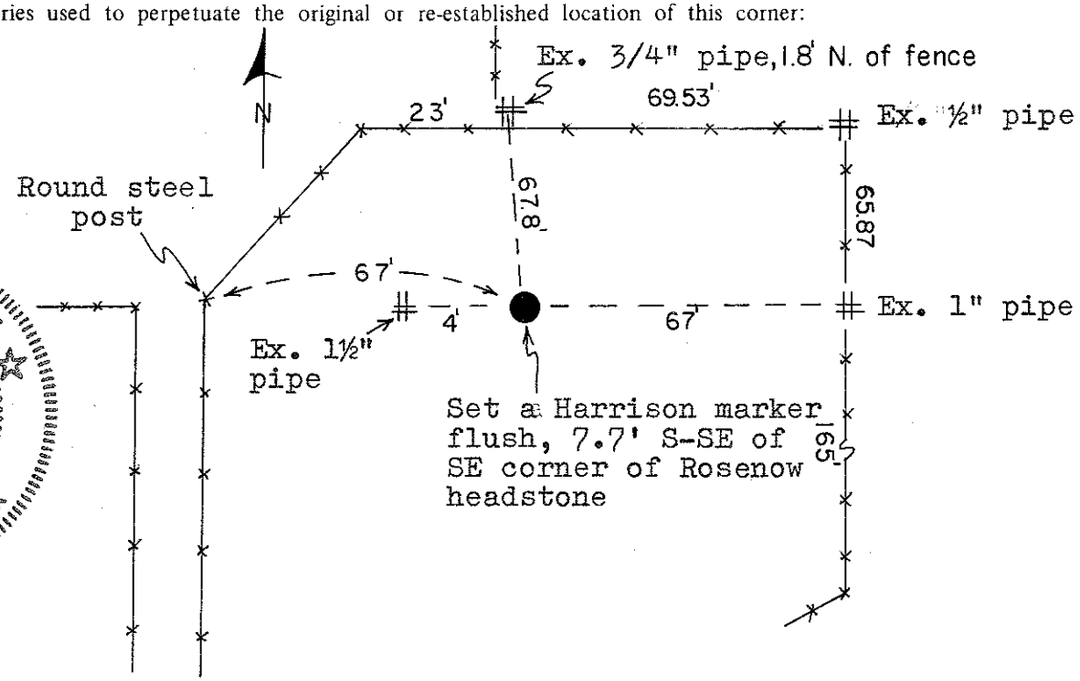

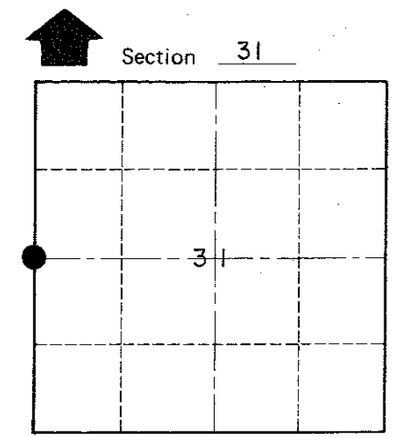

● = LOCATION CORNER

T 15 N R 2 W

WISCONSIN

SURVEY CONTROL ORDER

Horizontal	
Vertical	

WISCONSIN COORDINATE SYSTEM

	East (X)	North (Y)	Elevation (Z)	Zone
Corner				
Control Sta. Name				

~~City, Village~~ or Town Sheldon

County of Monroe
Wisconsin