U.S. PUBLIC LAND CORNER MAINTENANCE
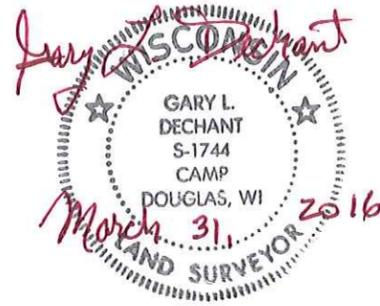
Corner ID : S1/4 Sec. 10, T19N-R4W

21904100020

DATE	CREW	MONUMENT TYPE -----------------------
March 17, 2016	Zachariah P.Dechant Gary L. Dechant	Harrison intact in pile of stones, south of bend in fence, Half way up west slope, Set sign 1' north

References:

	Bearing	Distance
1) Set 3/4"x24"hex iron bar, down 6", SW side of stone	N20E	25.55'
2) Set 3/4"x24" hex iron bar, down 6", 3' west of 4" Jack Pine and 3' north of a 4" Jack Pine	S1E	25.76'
3) Set 3/4"x24" hex iron bar, down 6"	S40W	17.21'
4) Set 3/4"x24" hex iron bar, down 6", 0n west side of stone	N5W	20.04'

WISCONSIN

GARY L.
DECHANT
S-1744
CAMP
DOUGLAS, WI

LAND SURVEYOR

March 31, 2016

I, __Bryan H. Meyer__, do hereby certify that on the __29th__ day of __March__ 19 84 , I found (evidence) ~~and evidence~~ of the __N¼__ corner of __Section 15__ , T __19__ N, R __4 W__ Fourth Principal Meridian, and I re-established said corner according to the Wisconsin Statutes as shown and described hereon.

Dated this __27th__ day of __Nov.__ 19 84 .

Bryan H. Meyer

Deputy County Surveyor
Title

History of corner establishment since Original Government Survey

Fred Holden was here in November of 1908.

See Reverse Side
For Maintenance

Description of corner evidence found:

I accepted the intersection of fence projections from East, West and South, as the best available evidence.
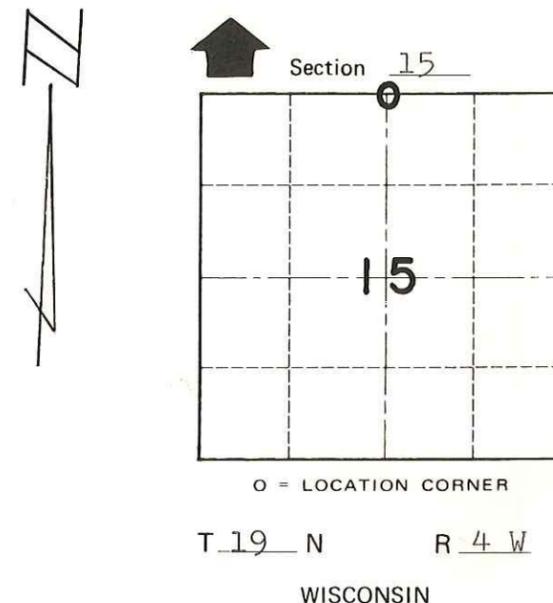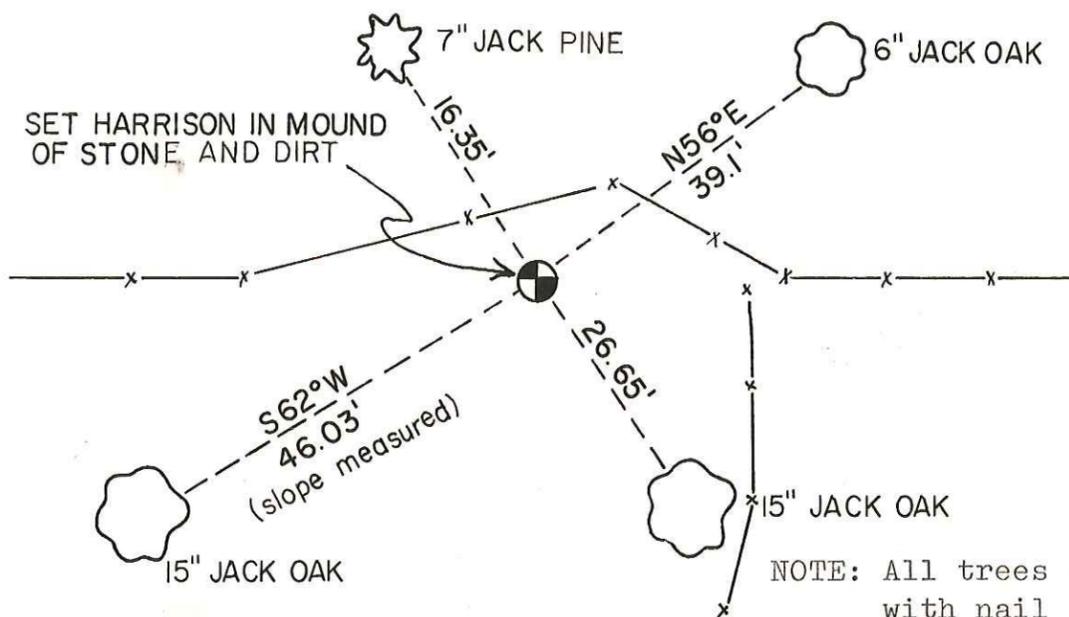
COUNTY SURVEYOR FORM NO. 1

Description of corner and witness monuments, references and accessories used to perpetuate the original or re-established location of this corner:

Crew: Meyer, Jung
Date: March 29, 1984 - 1:15 P.M.
Weather: Overcast, Snow, 30°±

Witnesses to corner location:

Bryan Meyer

Bill Jung

SET HARRISON IN MOUND OF STONE AND DIRT

7" JACK PINE — 16.35'
6" JACK OAK — N56°E 39.1'
S62°W 46.03' (slope measured) — 15" JACK OAK
26.65' — 15" JACK OAK

Section 15

15

O = LOCATION CORNER

T 19 N   R 4 W
WISCONSIN

NOTE: All trees are double blazed with nail in hack, an "M" is scribed in the upper blaze of each tree. All brgs. are hand mag. compass brgs.

SURVEY CONTROL ORDER

Horizontal	
Vertical	

WISCONSIN COORDINATE SYSTEM

	East (X)	North (Y)	Elevation (Z)	Zone
Corner				
Control Sta. Name				

~~City Village or~~ Town __Little Falls__

County of __Monroe__