


Lincoln PLSS Corner Coordinates - SE

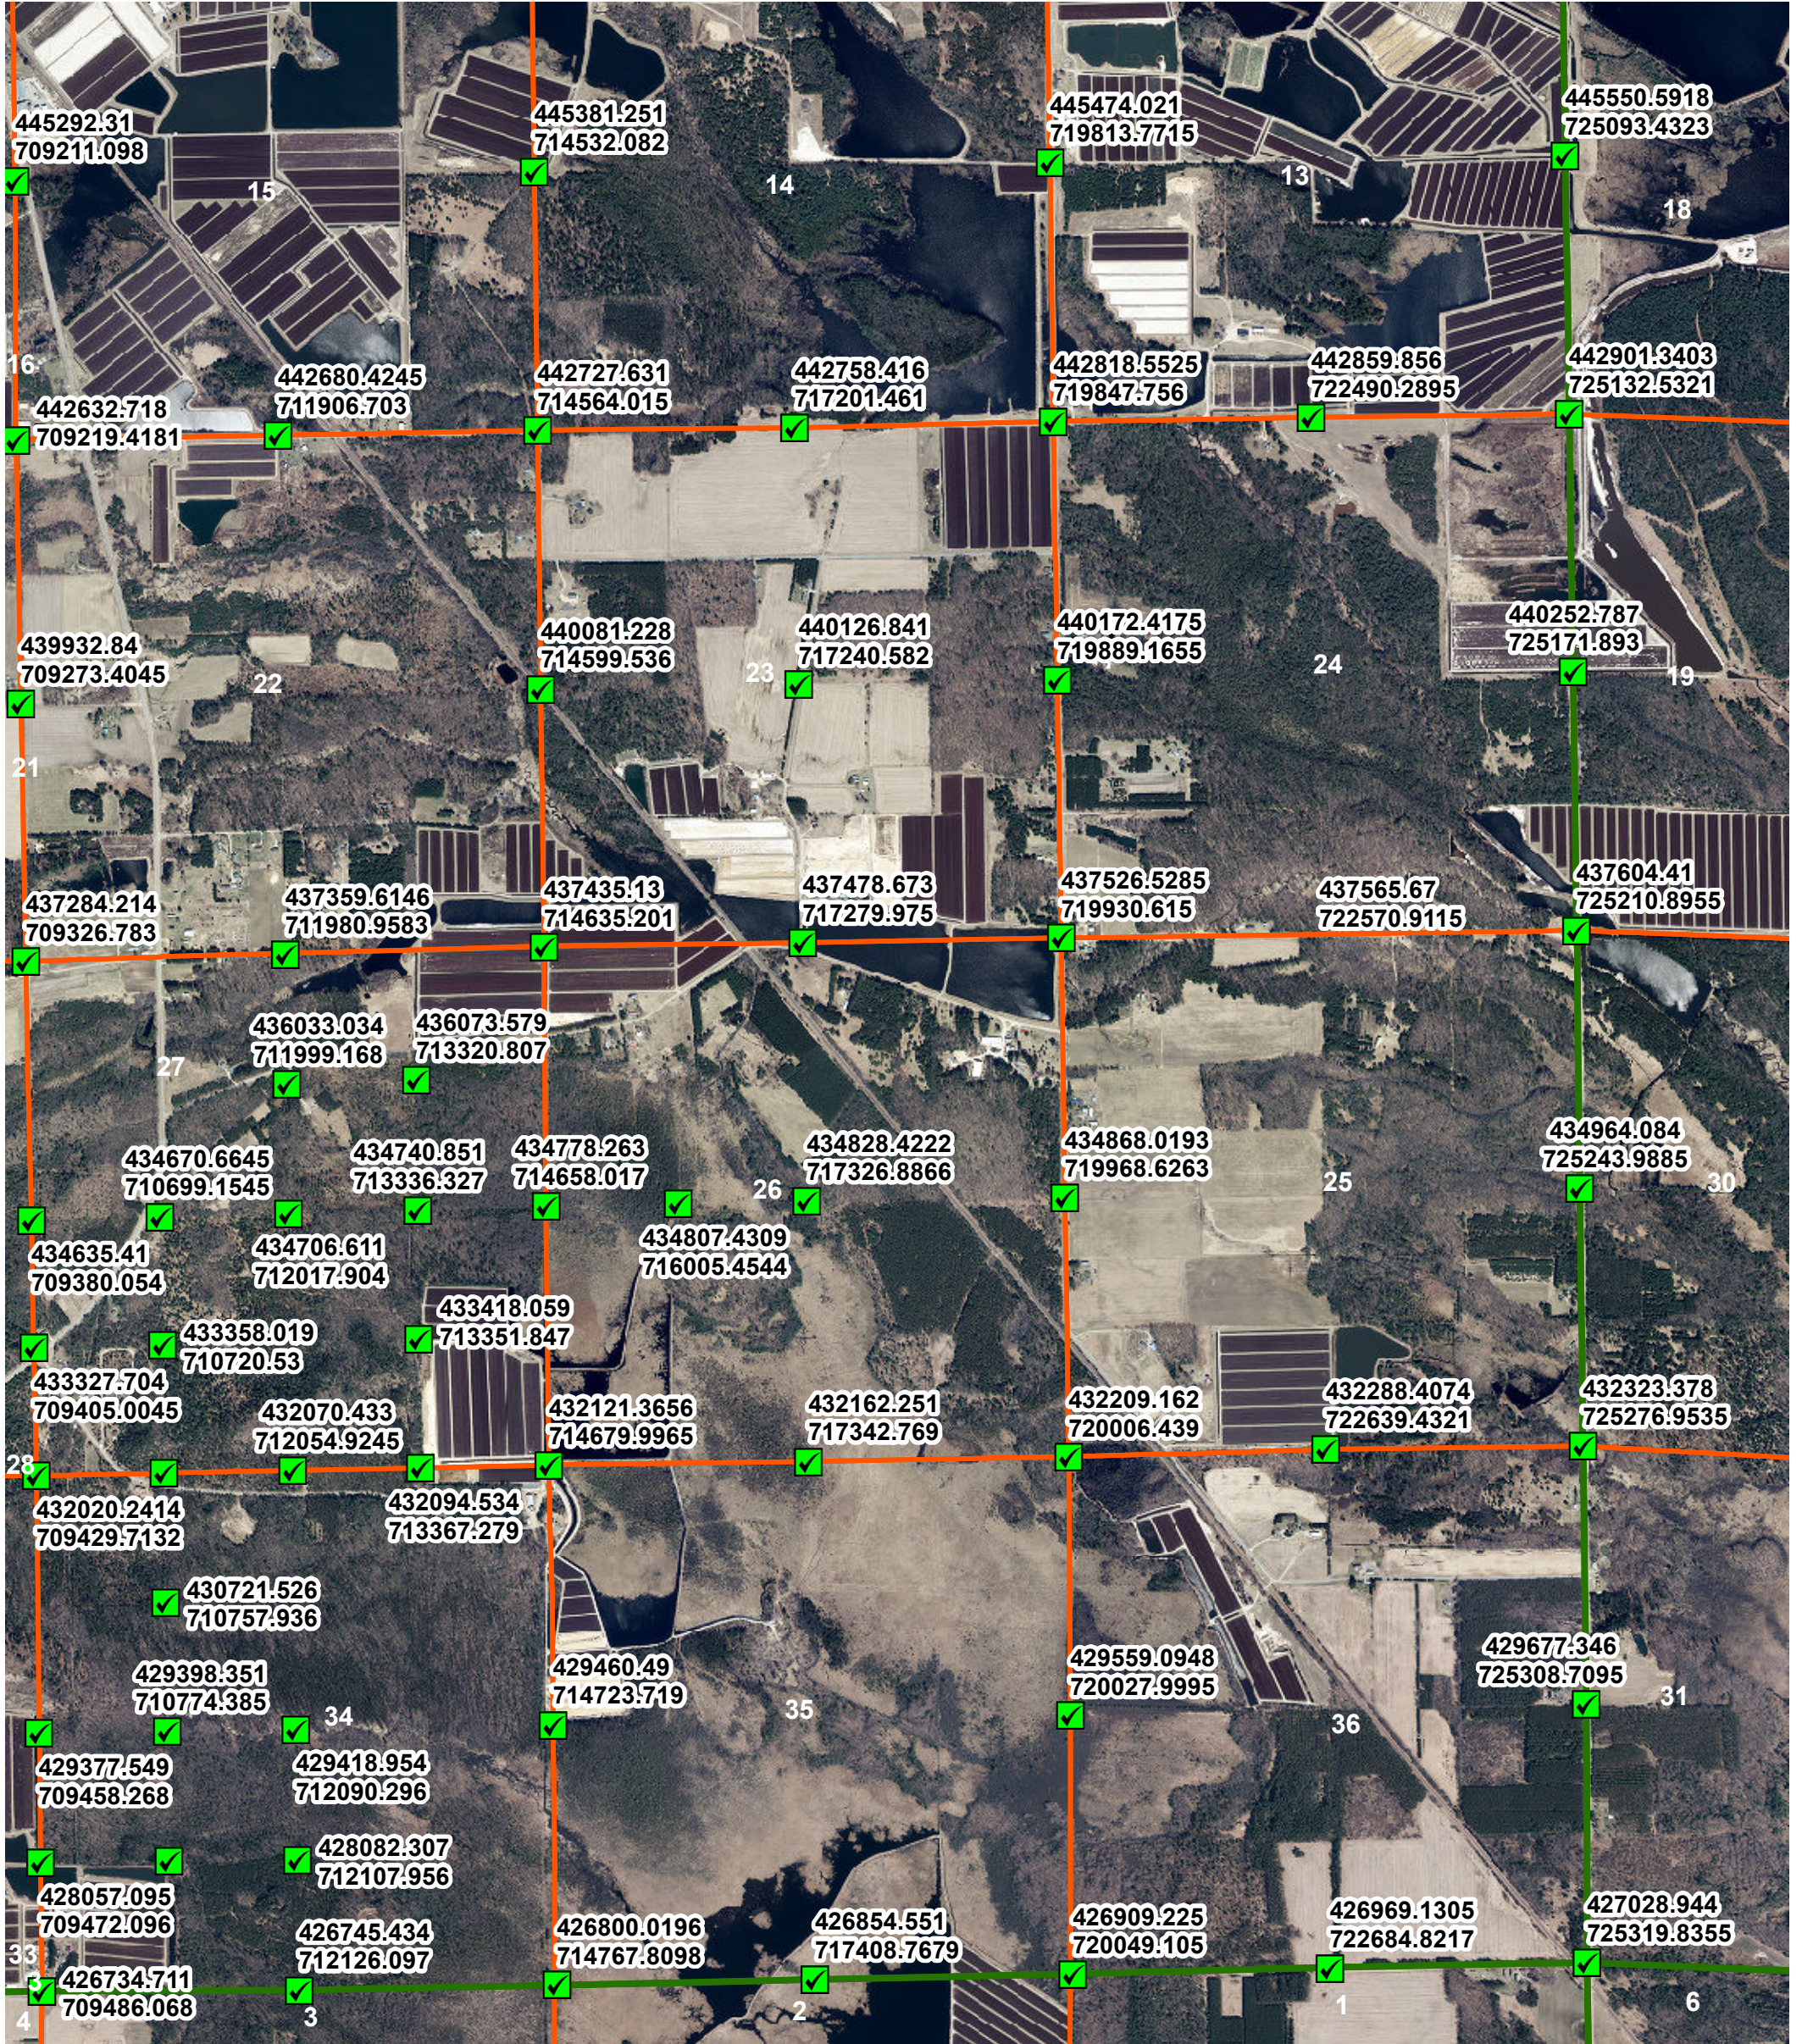

Legend

PLSS Coordinates

Coordinate Method

GPS

Date: 4/4/2021