


# Little Falls (T19N-R5W) PLSS Corner Coordinates - N

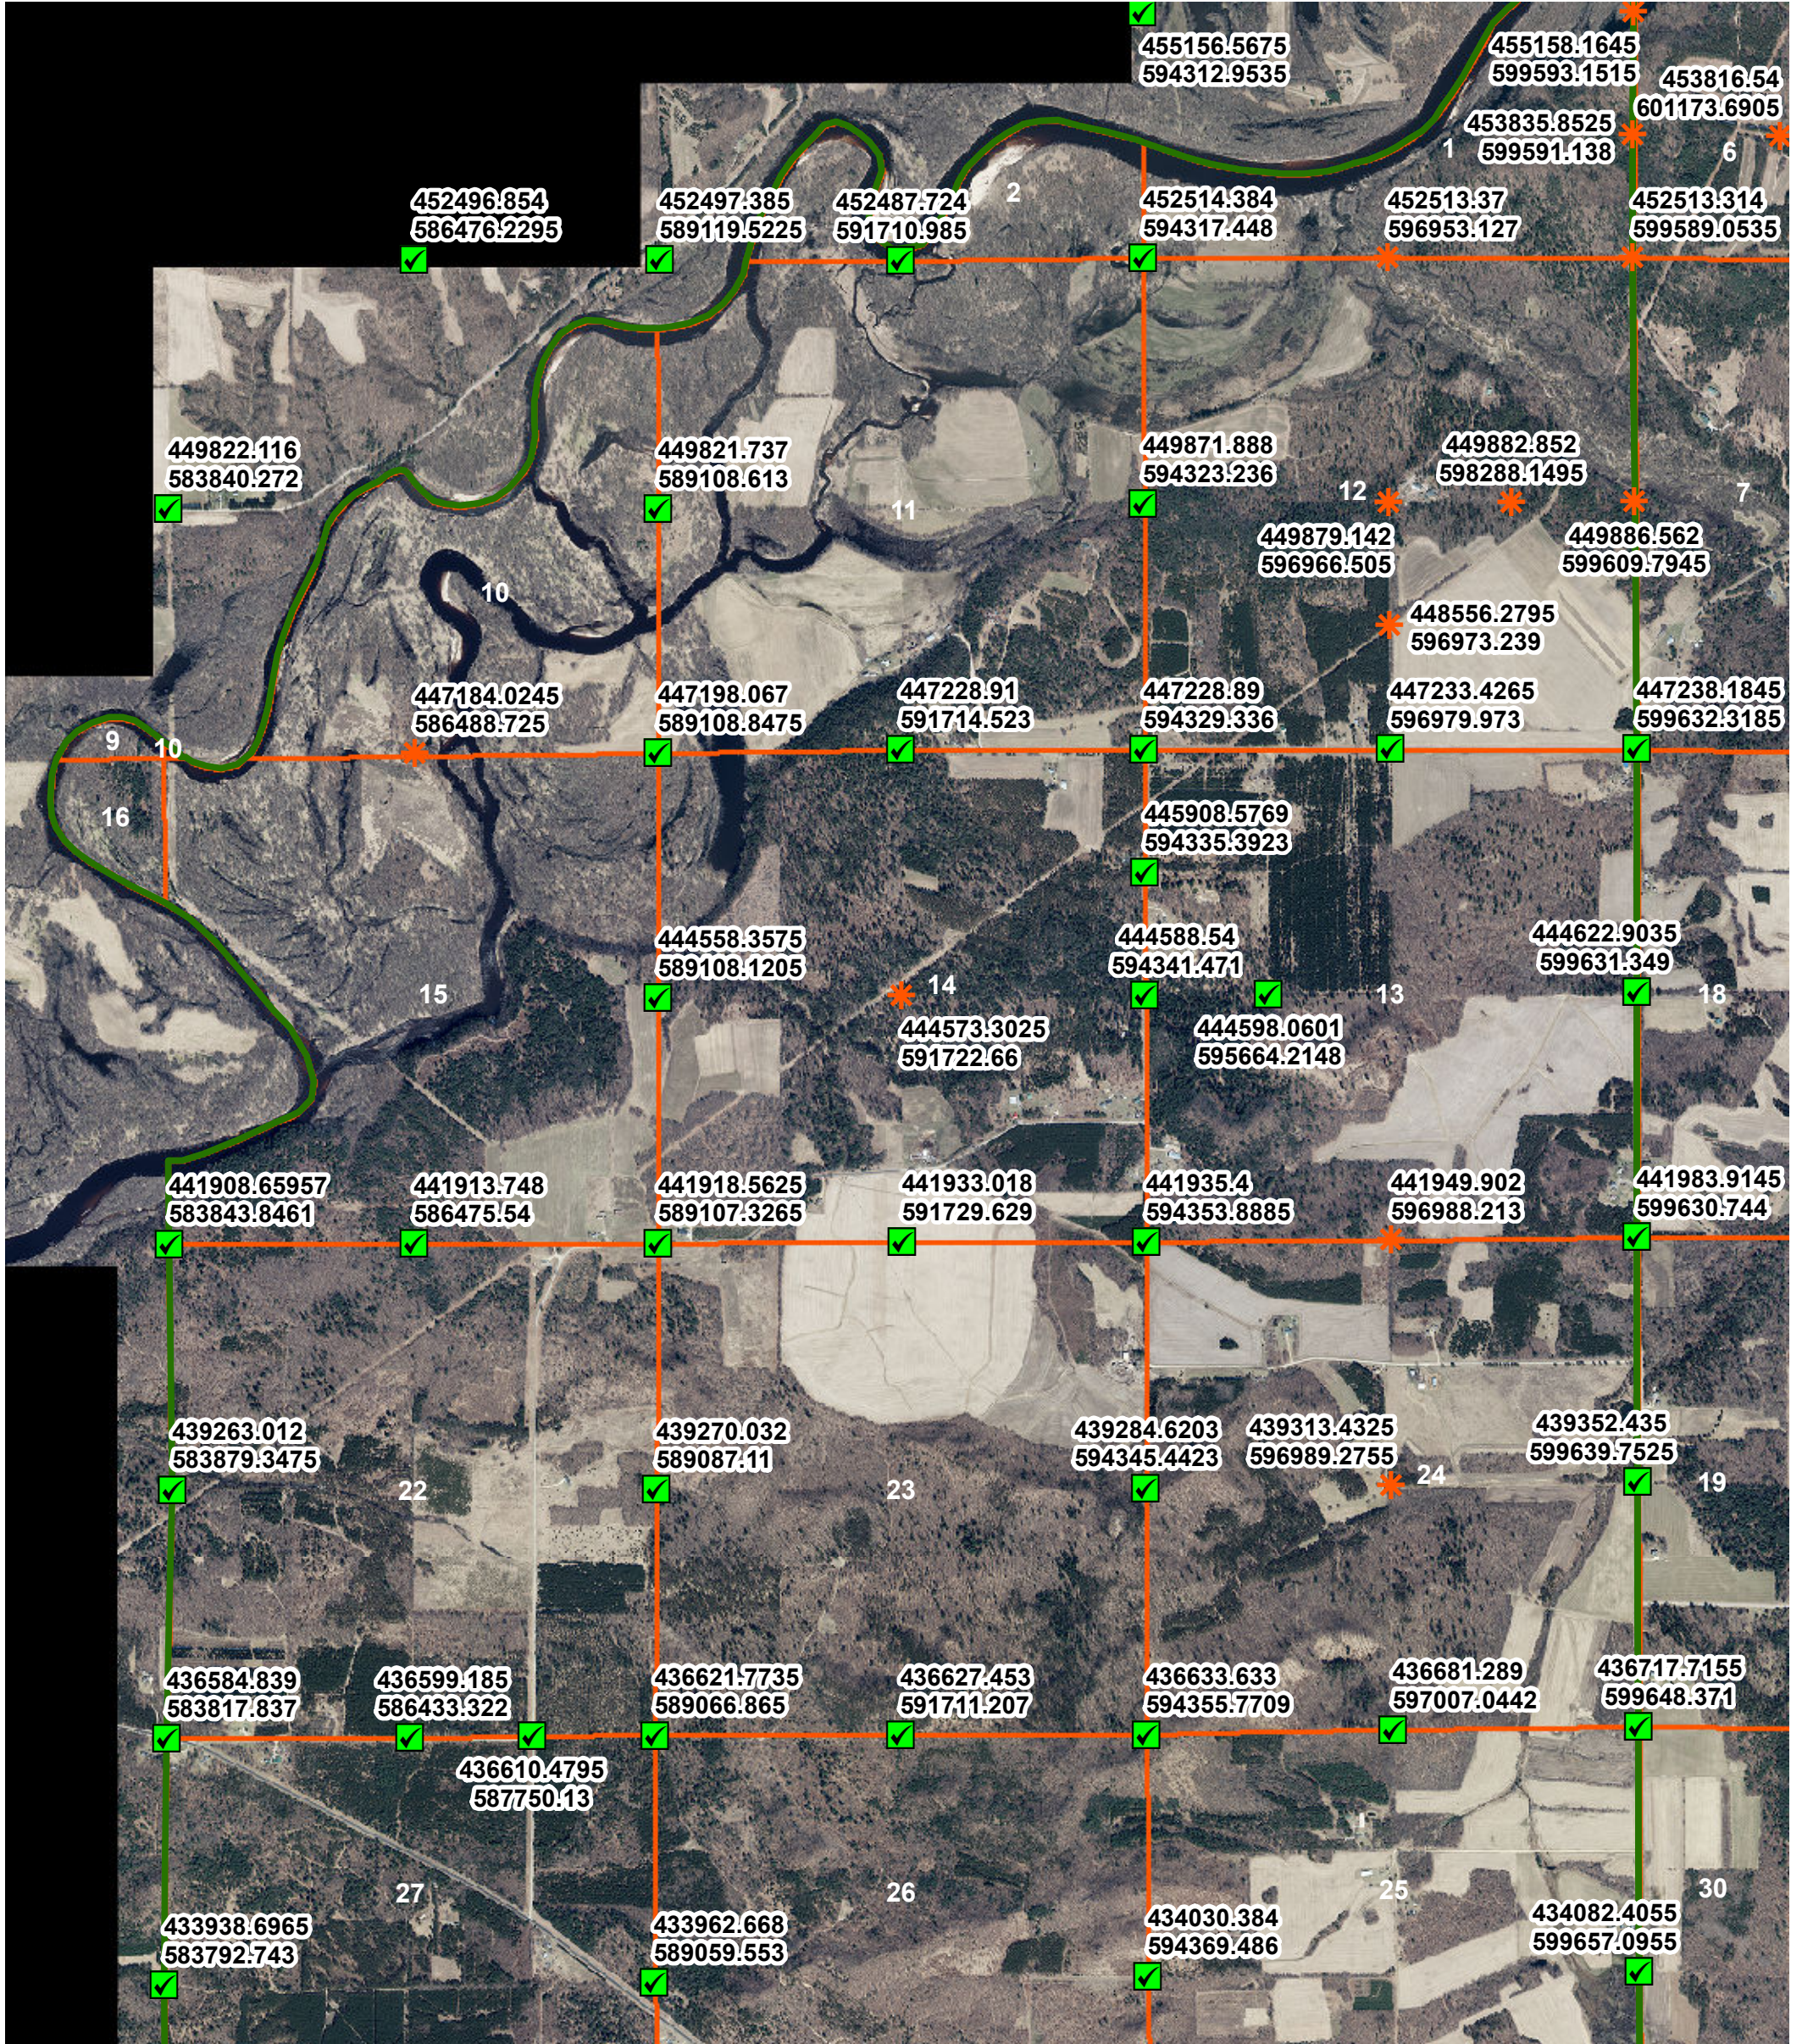

**Legend**  
**PLSS Coordinates**  
**Coordinate Method**

- \* Derived
- ✔ GPS

Date: 4/4/2021