


Scott PLSS Corner Coordinates - NW

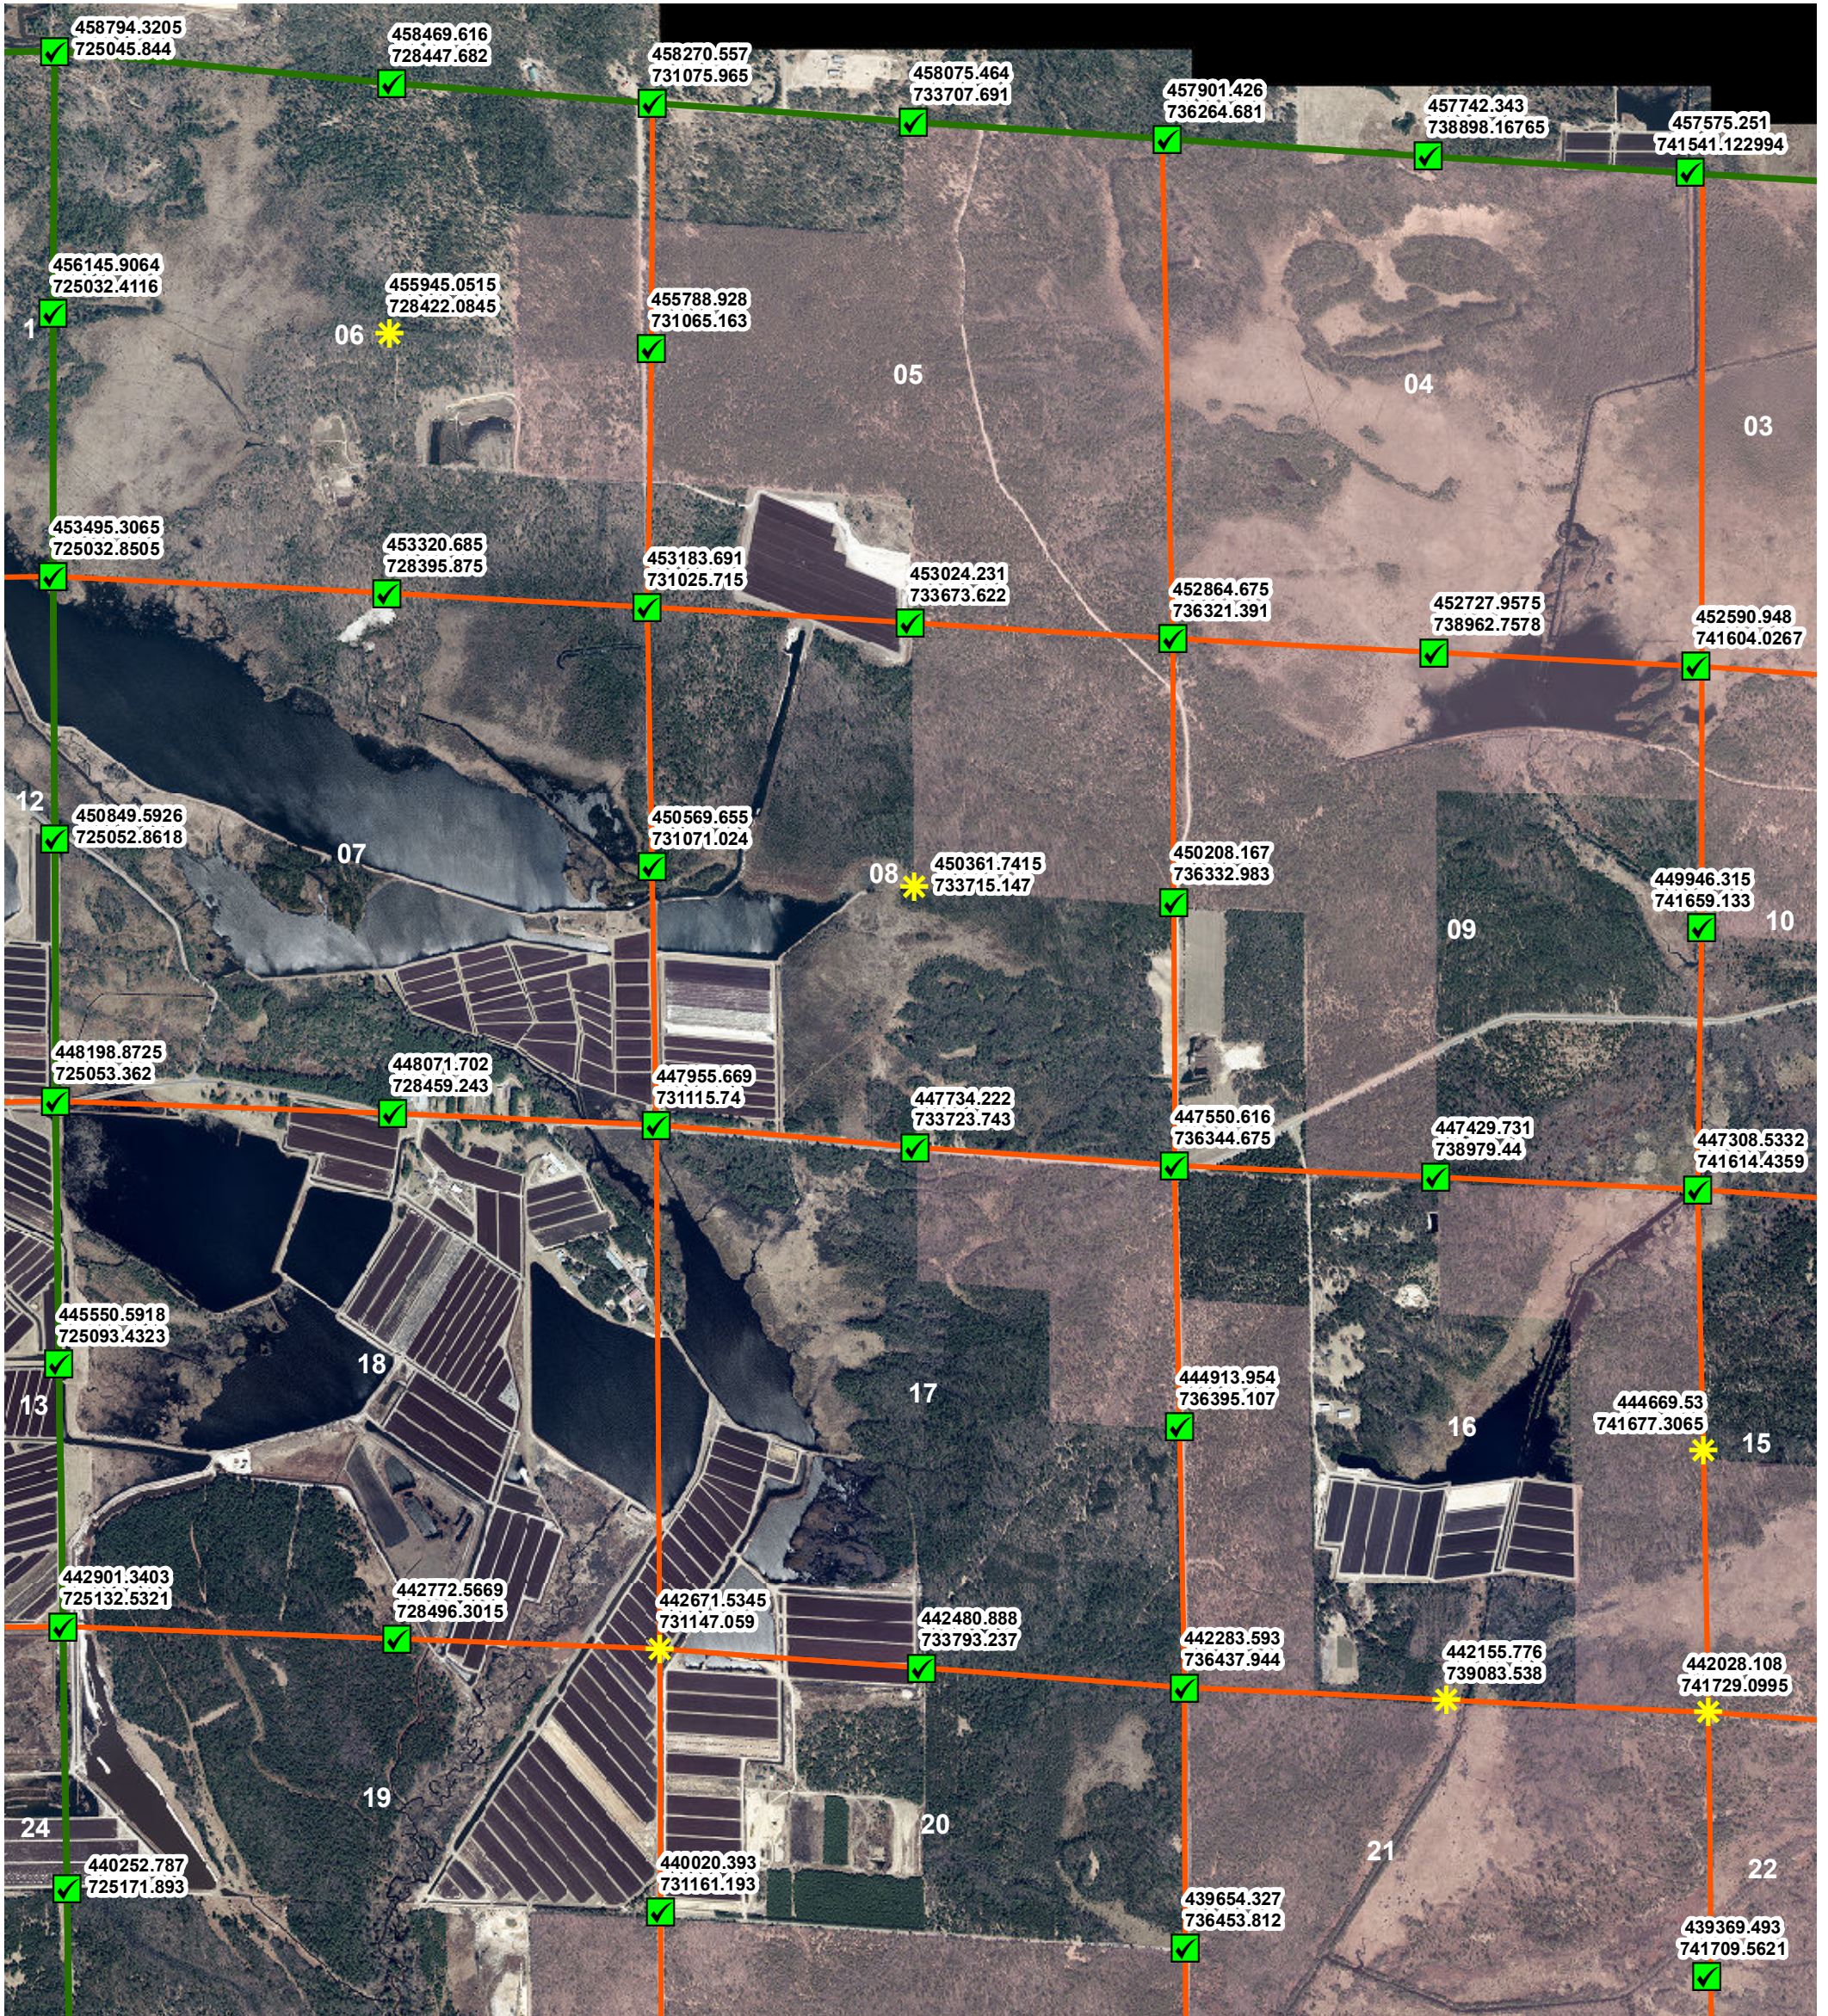

Legend

PLSS Coordinates
Coordinate Method

- * Derived
- ✔ GPS

Date: 4/26/2021