


# Scott PLSS Corner Coordinates - SW

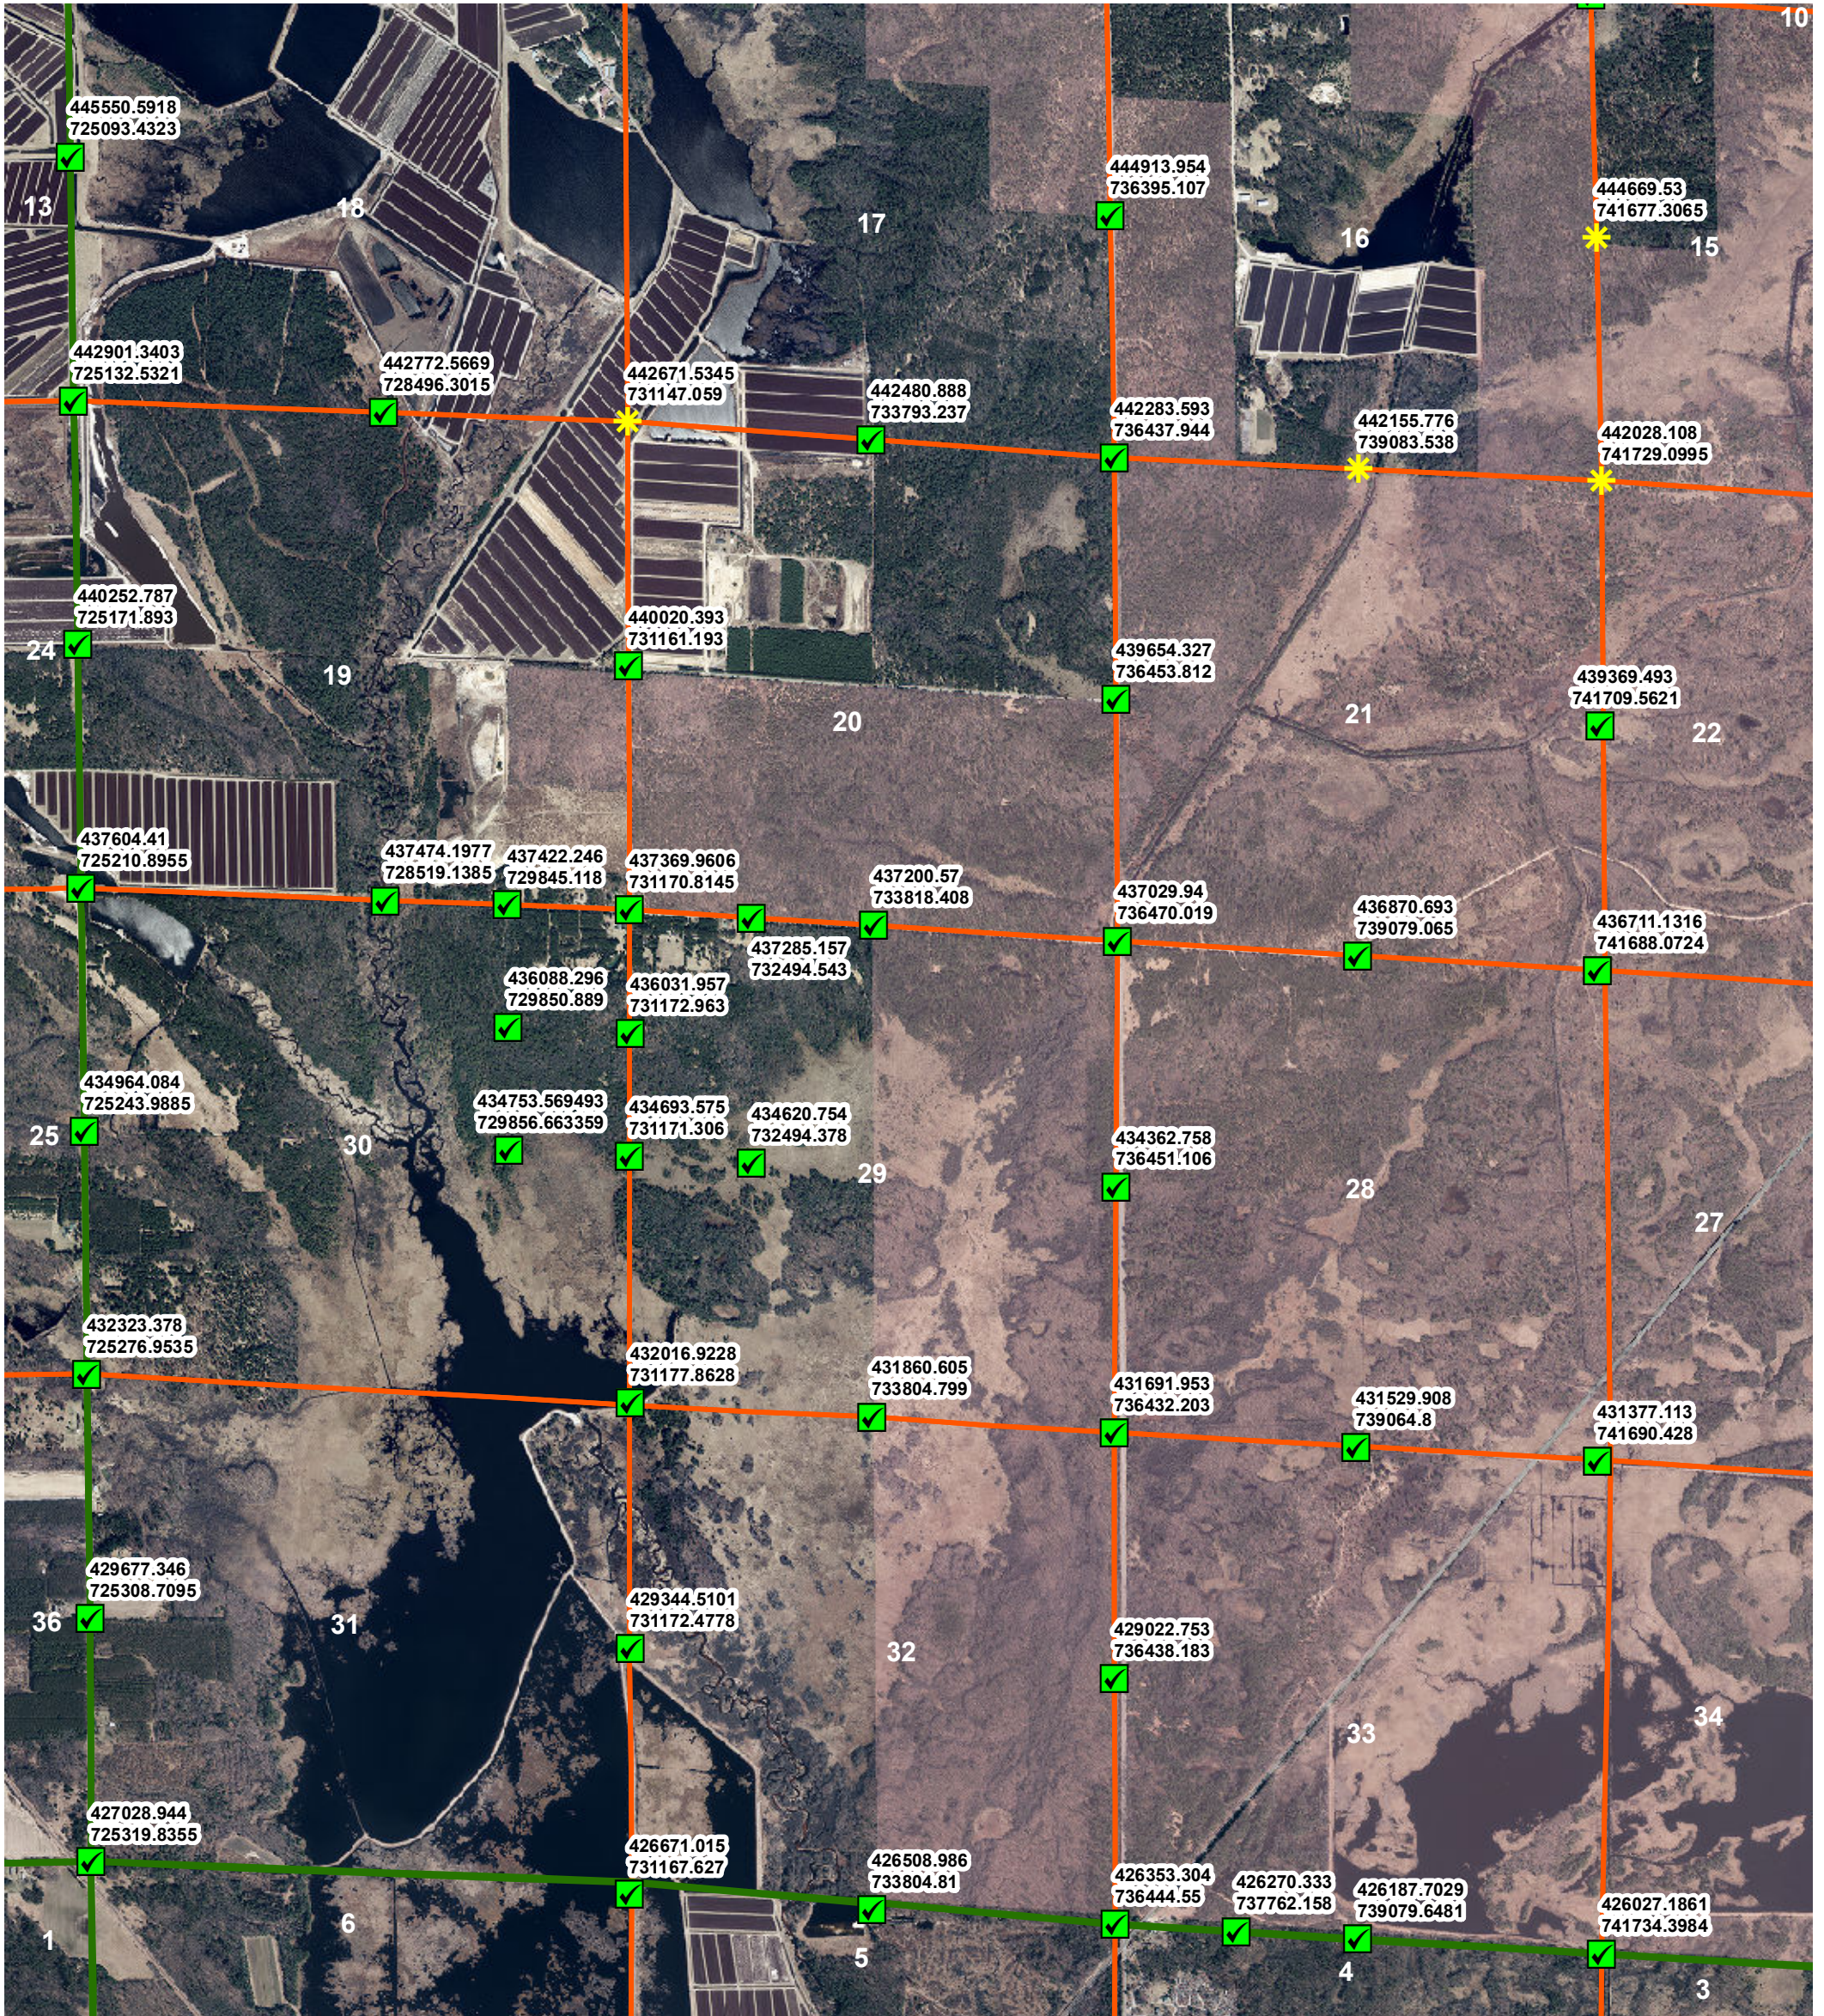

## Legend

### PLSS Coordinates Coordinate Method

- \* Derived
- ✔ GPS

Date: 4/26/2021