


# Little Falls (T19N-R4W) PLS Coordinate Coordinates - SE

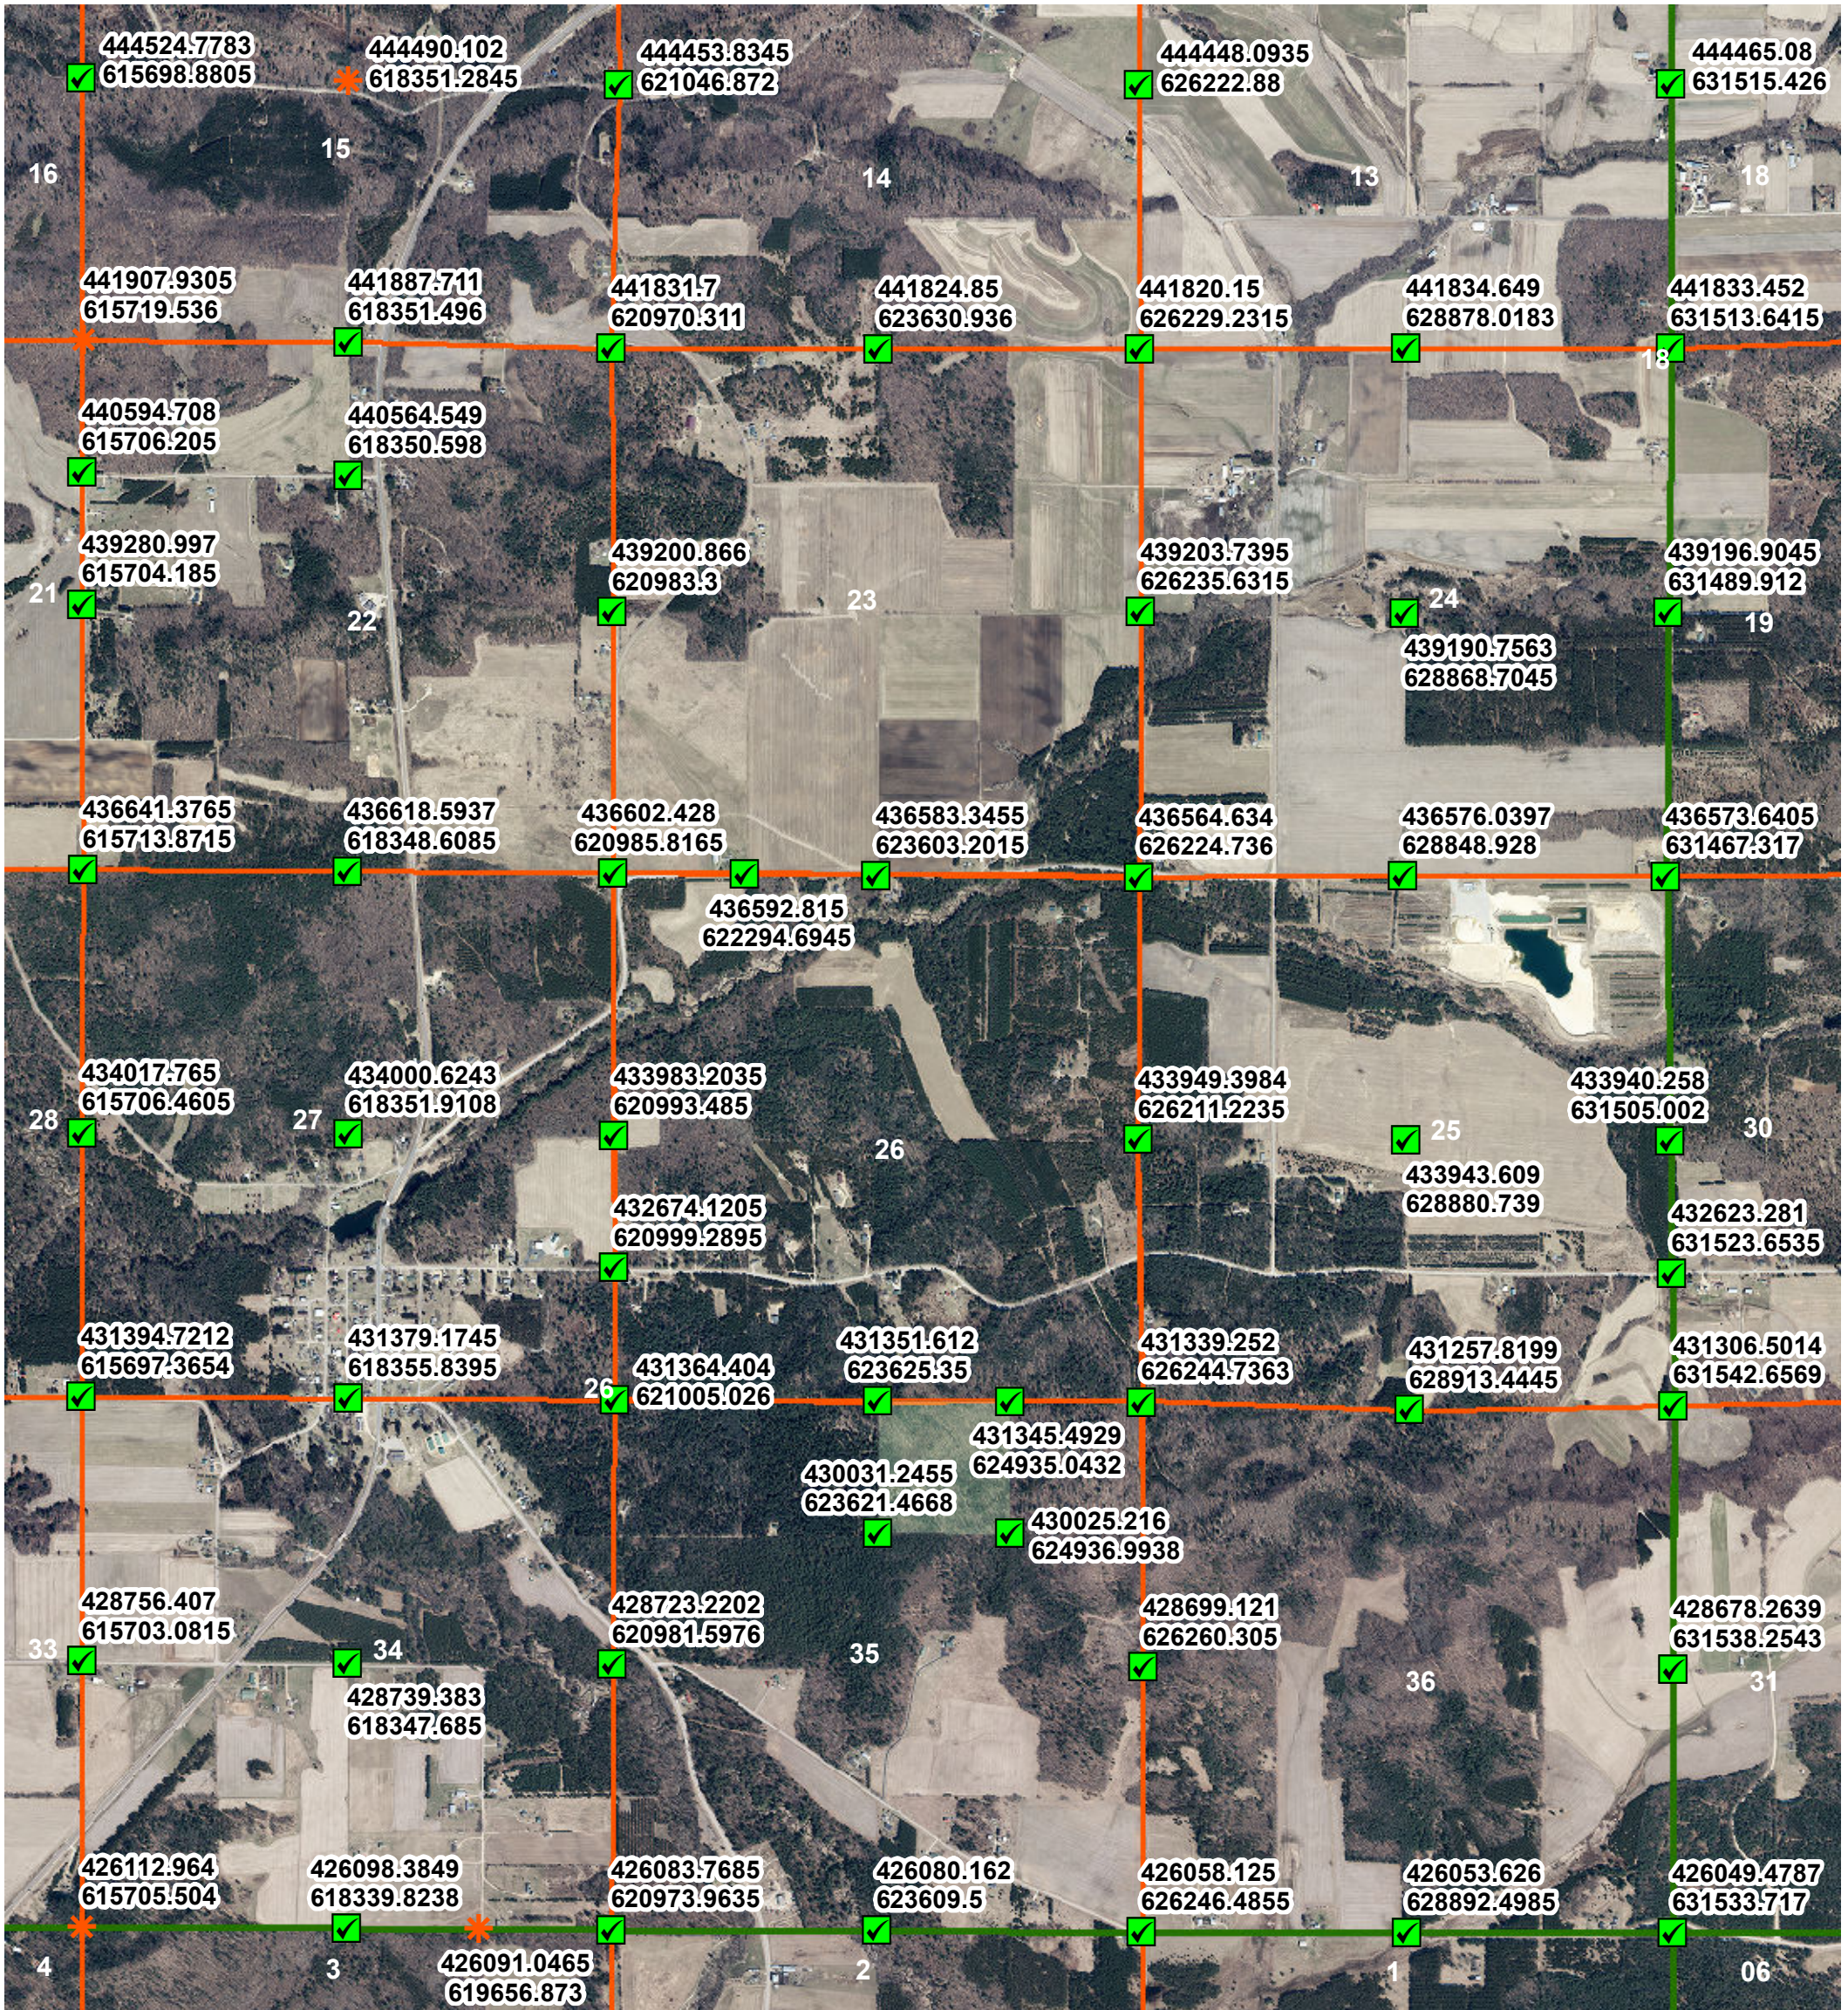

## Legend

### PLSS Coordinates

#### Coordinate Method

★ Derived

✔ GPS

Monroe County Forest

Date: 5/8/2021