


T 18N-R4W PLS S Corner Coordinates - NW

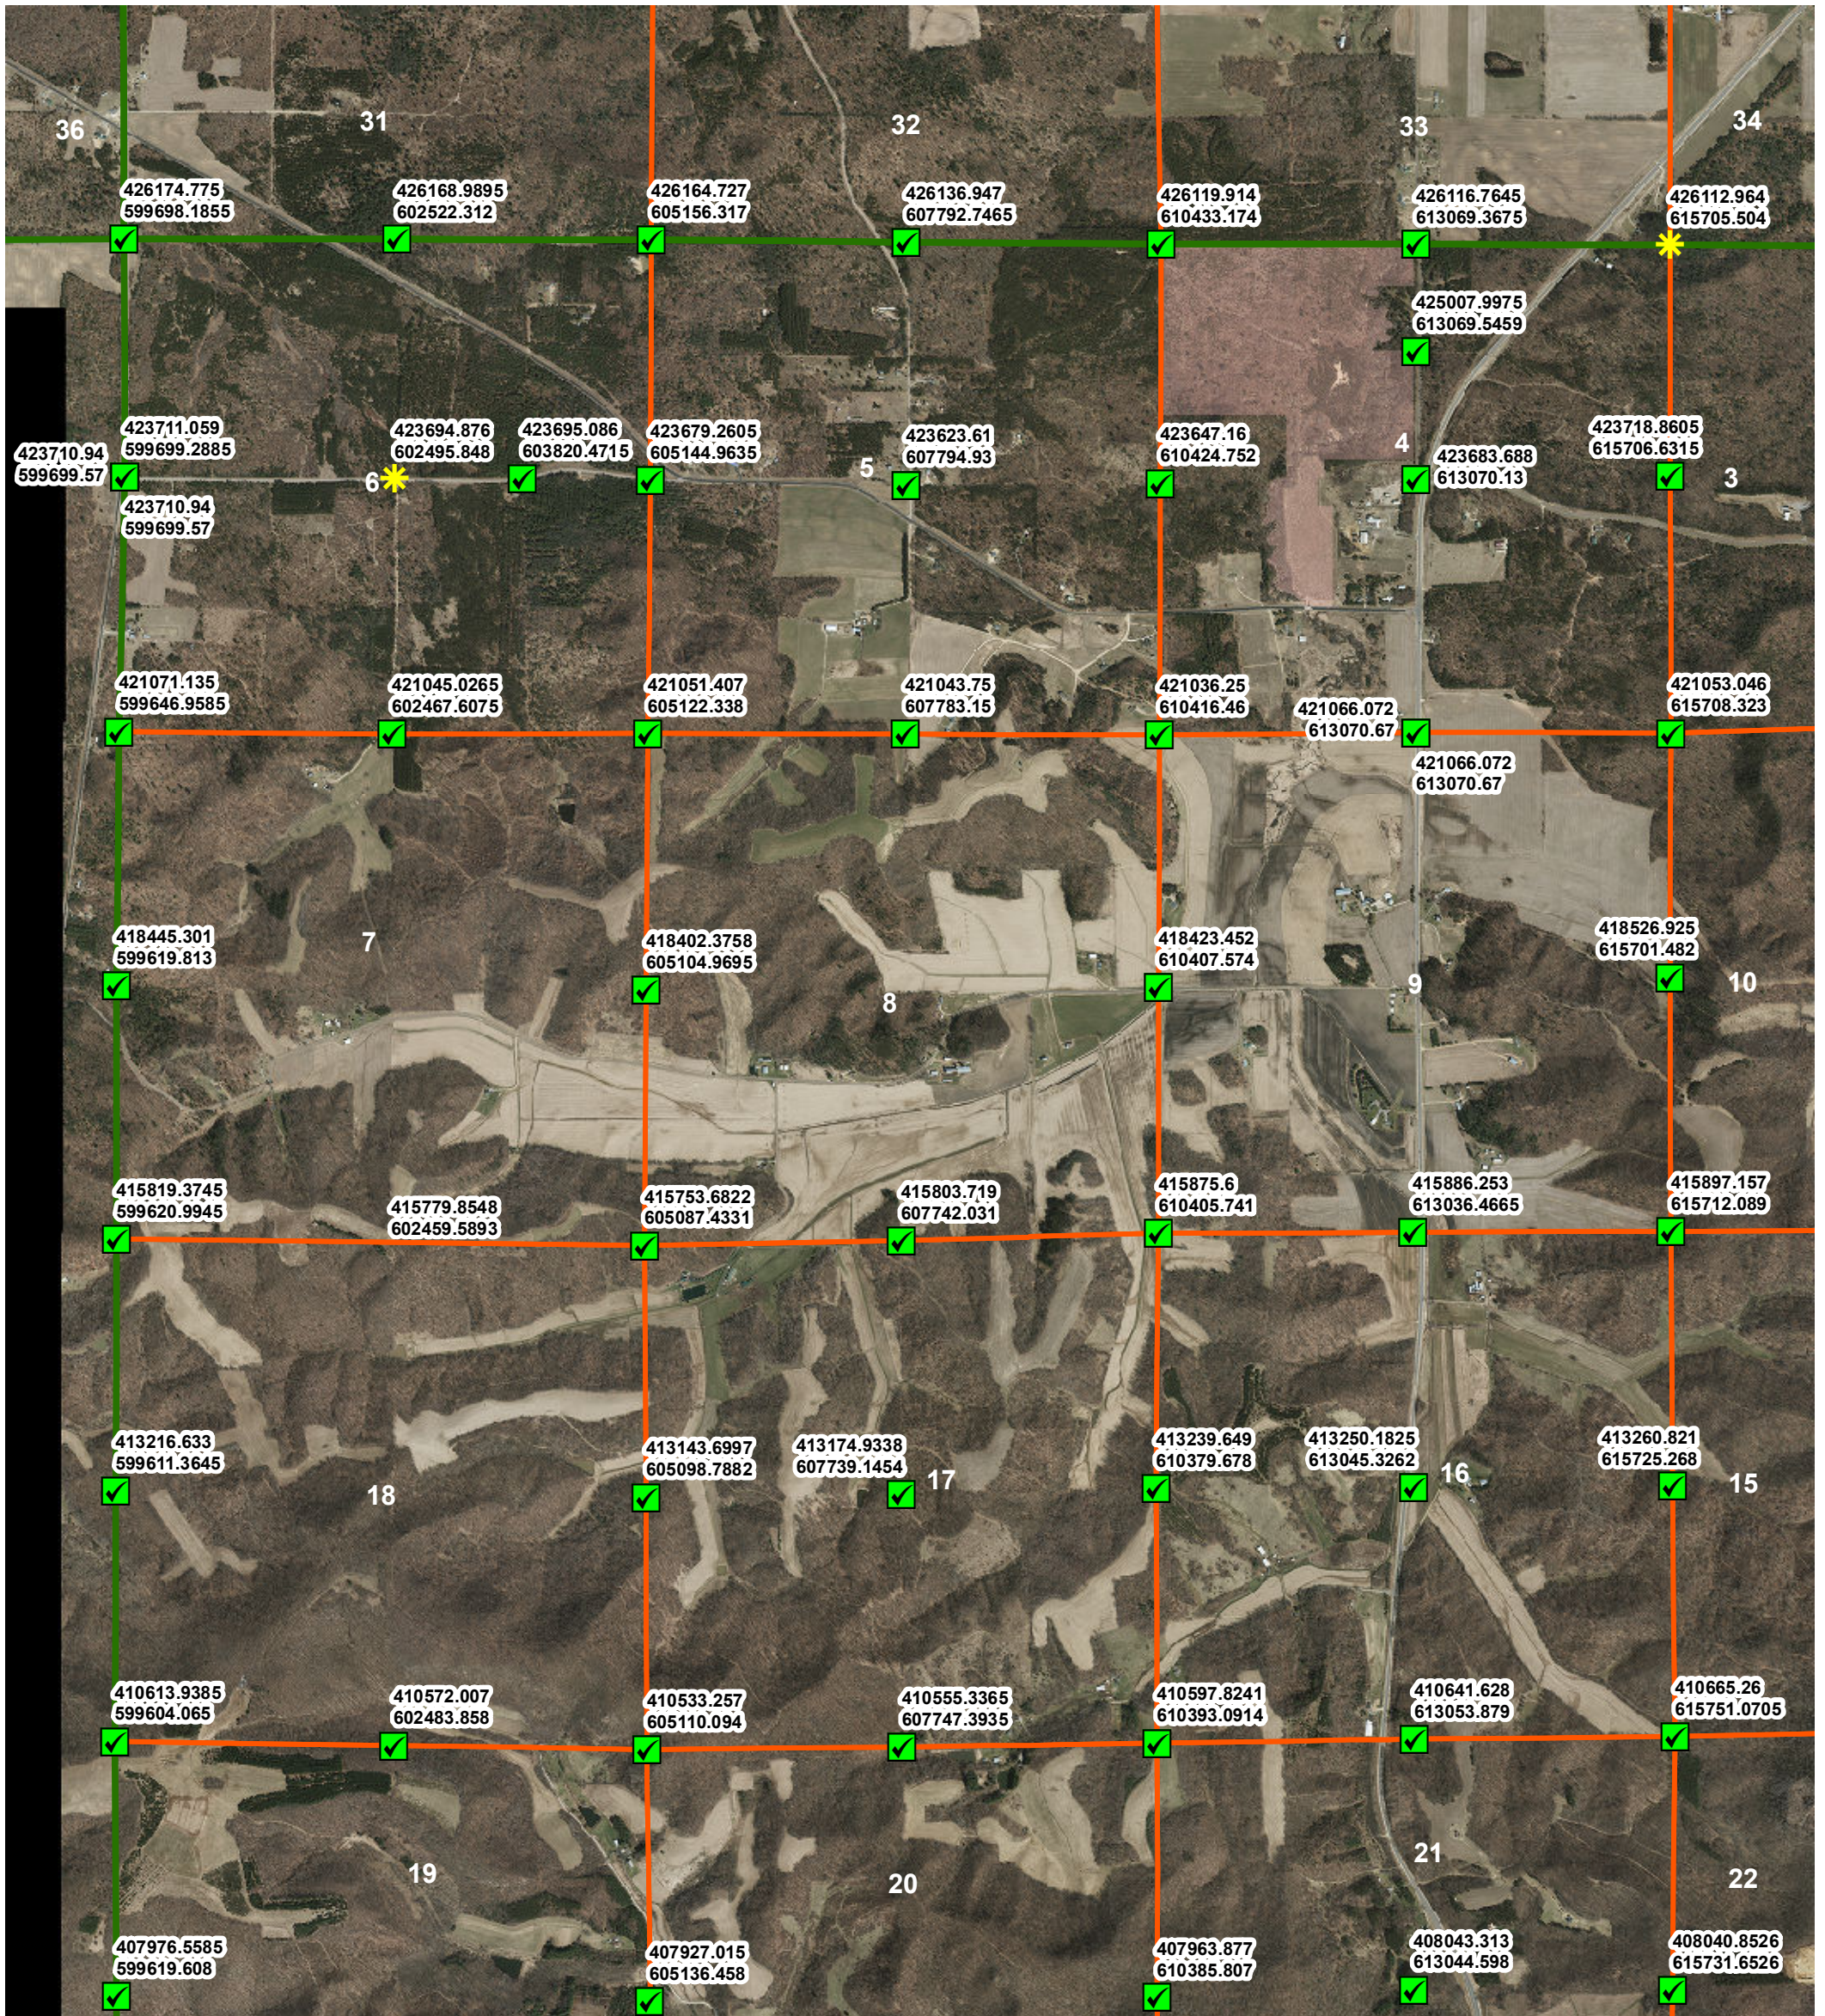

Legend

PLSS Coordinates Coordinate Method

- * Derived
- ✔ GPS