


Leon PLSS Corner Coordinates - SW

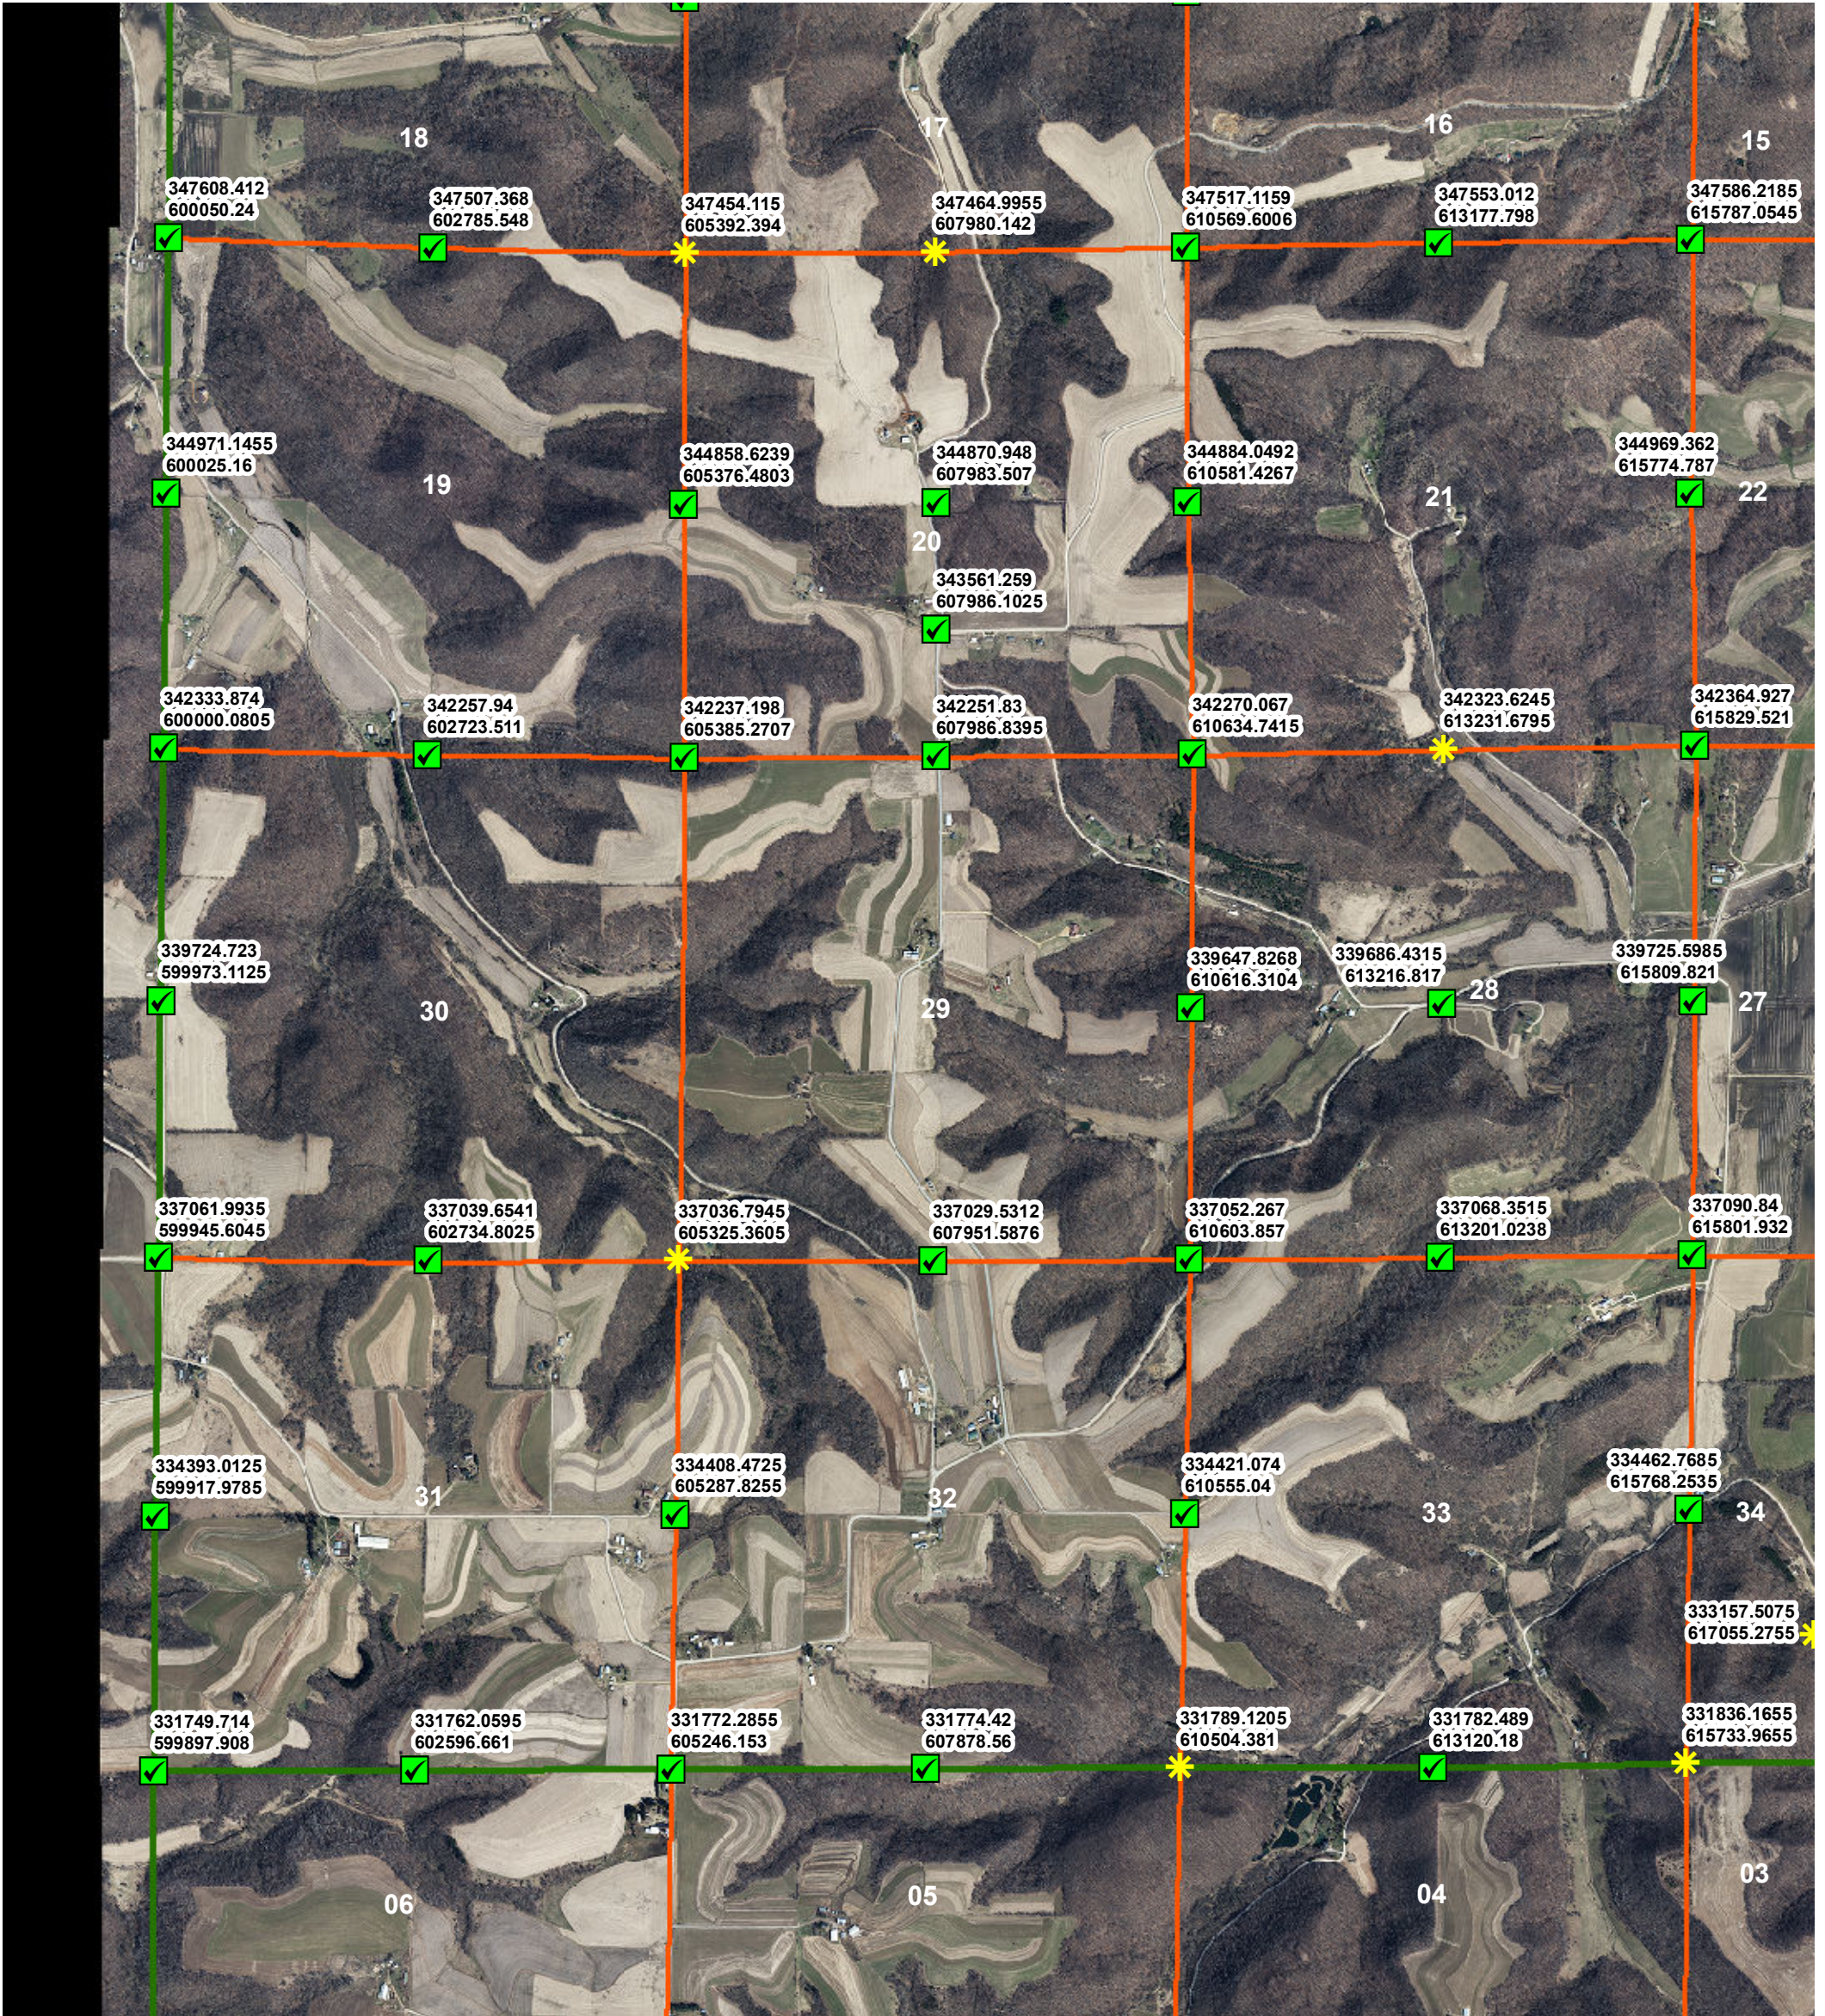

Legend

PLSS Coordinates Coordinate Method

- * Derived
- ✔ GPS

Date: 6/28/2021