


# LaGrange PLSS Corner Coordinates - SW

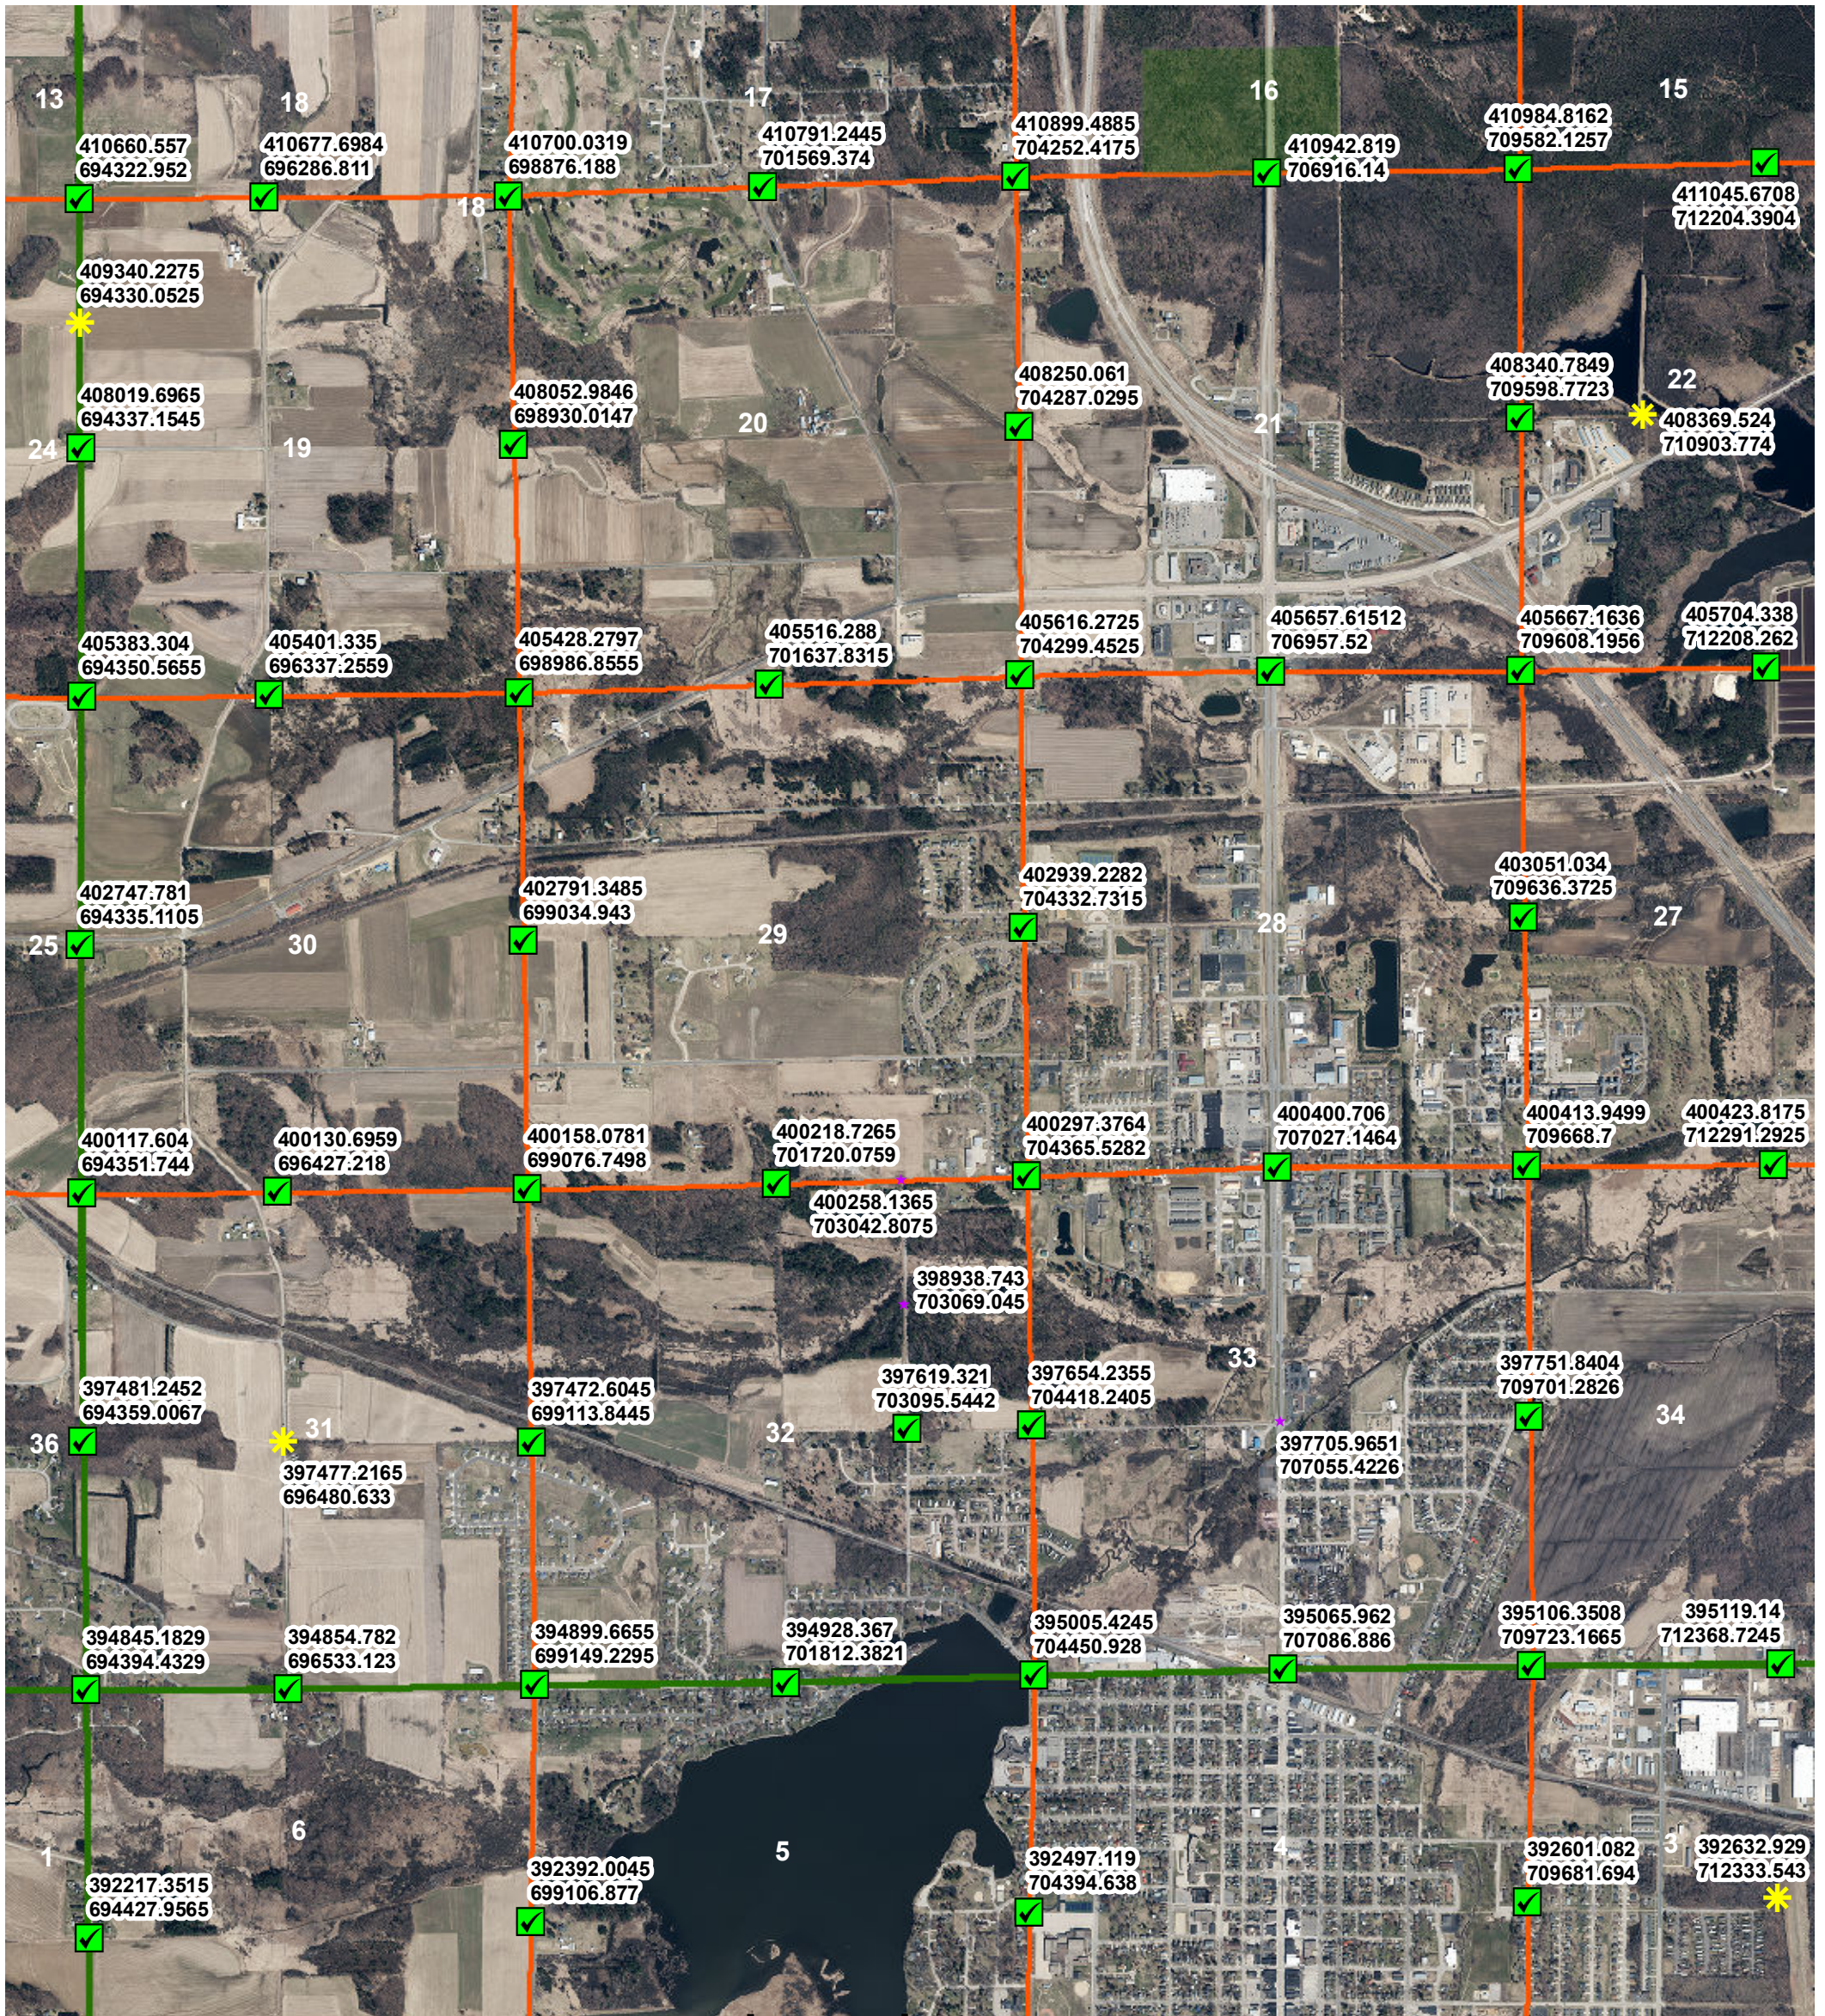

## Legend

### PLSS Coordinates Coordinate Method

- \* Unknown
- \* Derived
- ✔ GPS
- County\_Forest\_Boundaries