


Grant PLSS Corner Coordinates - NE

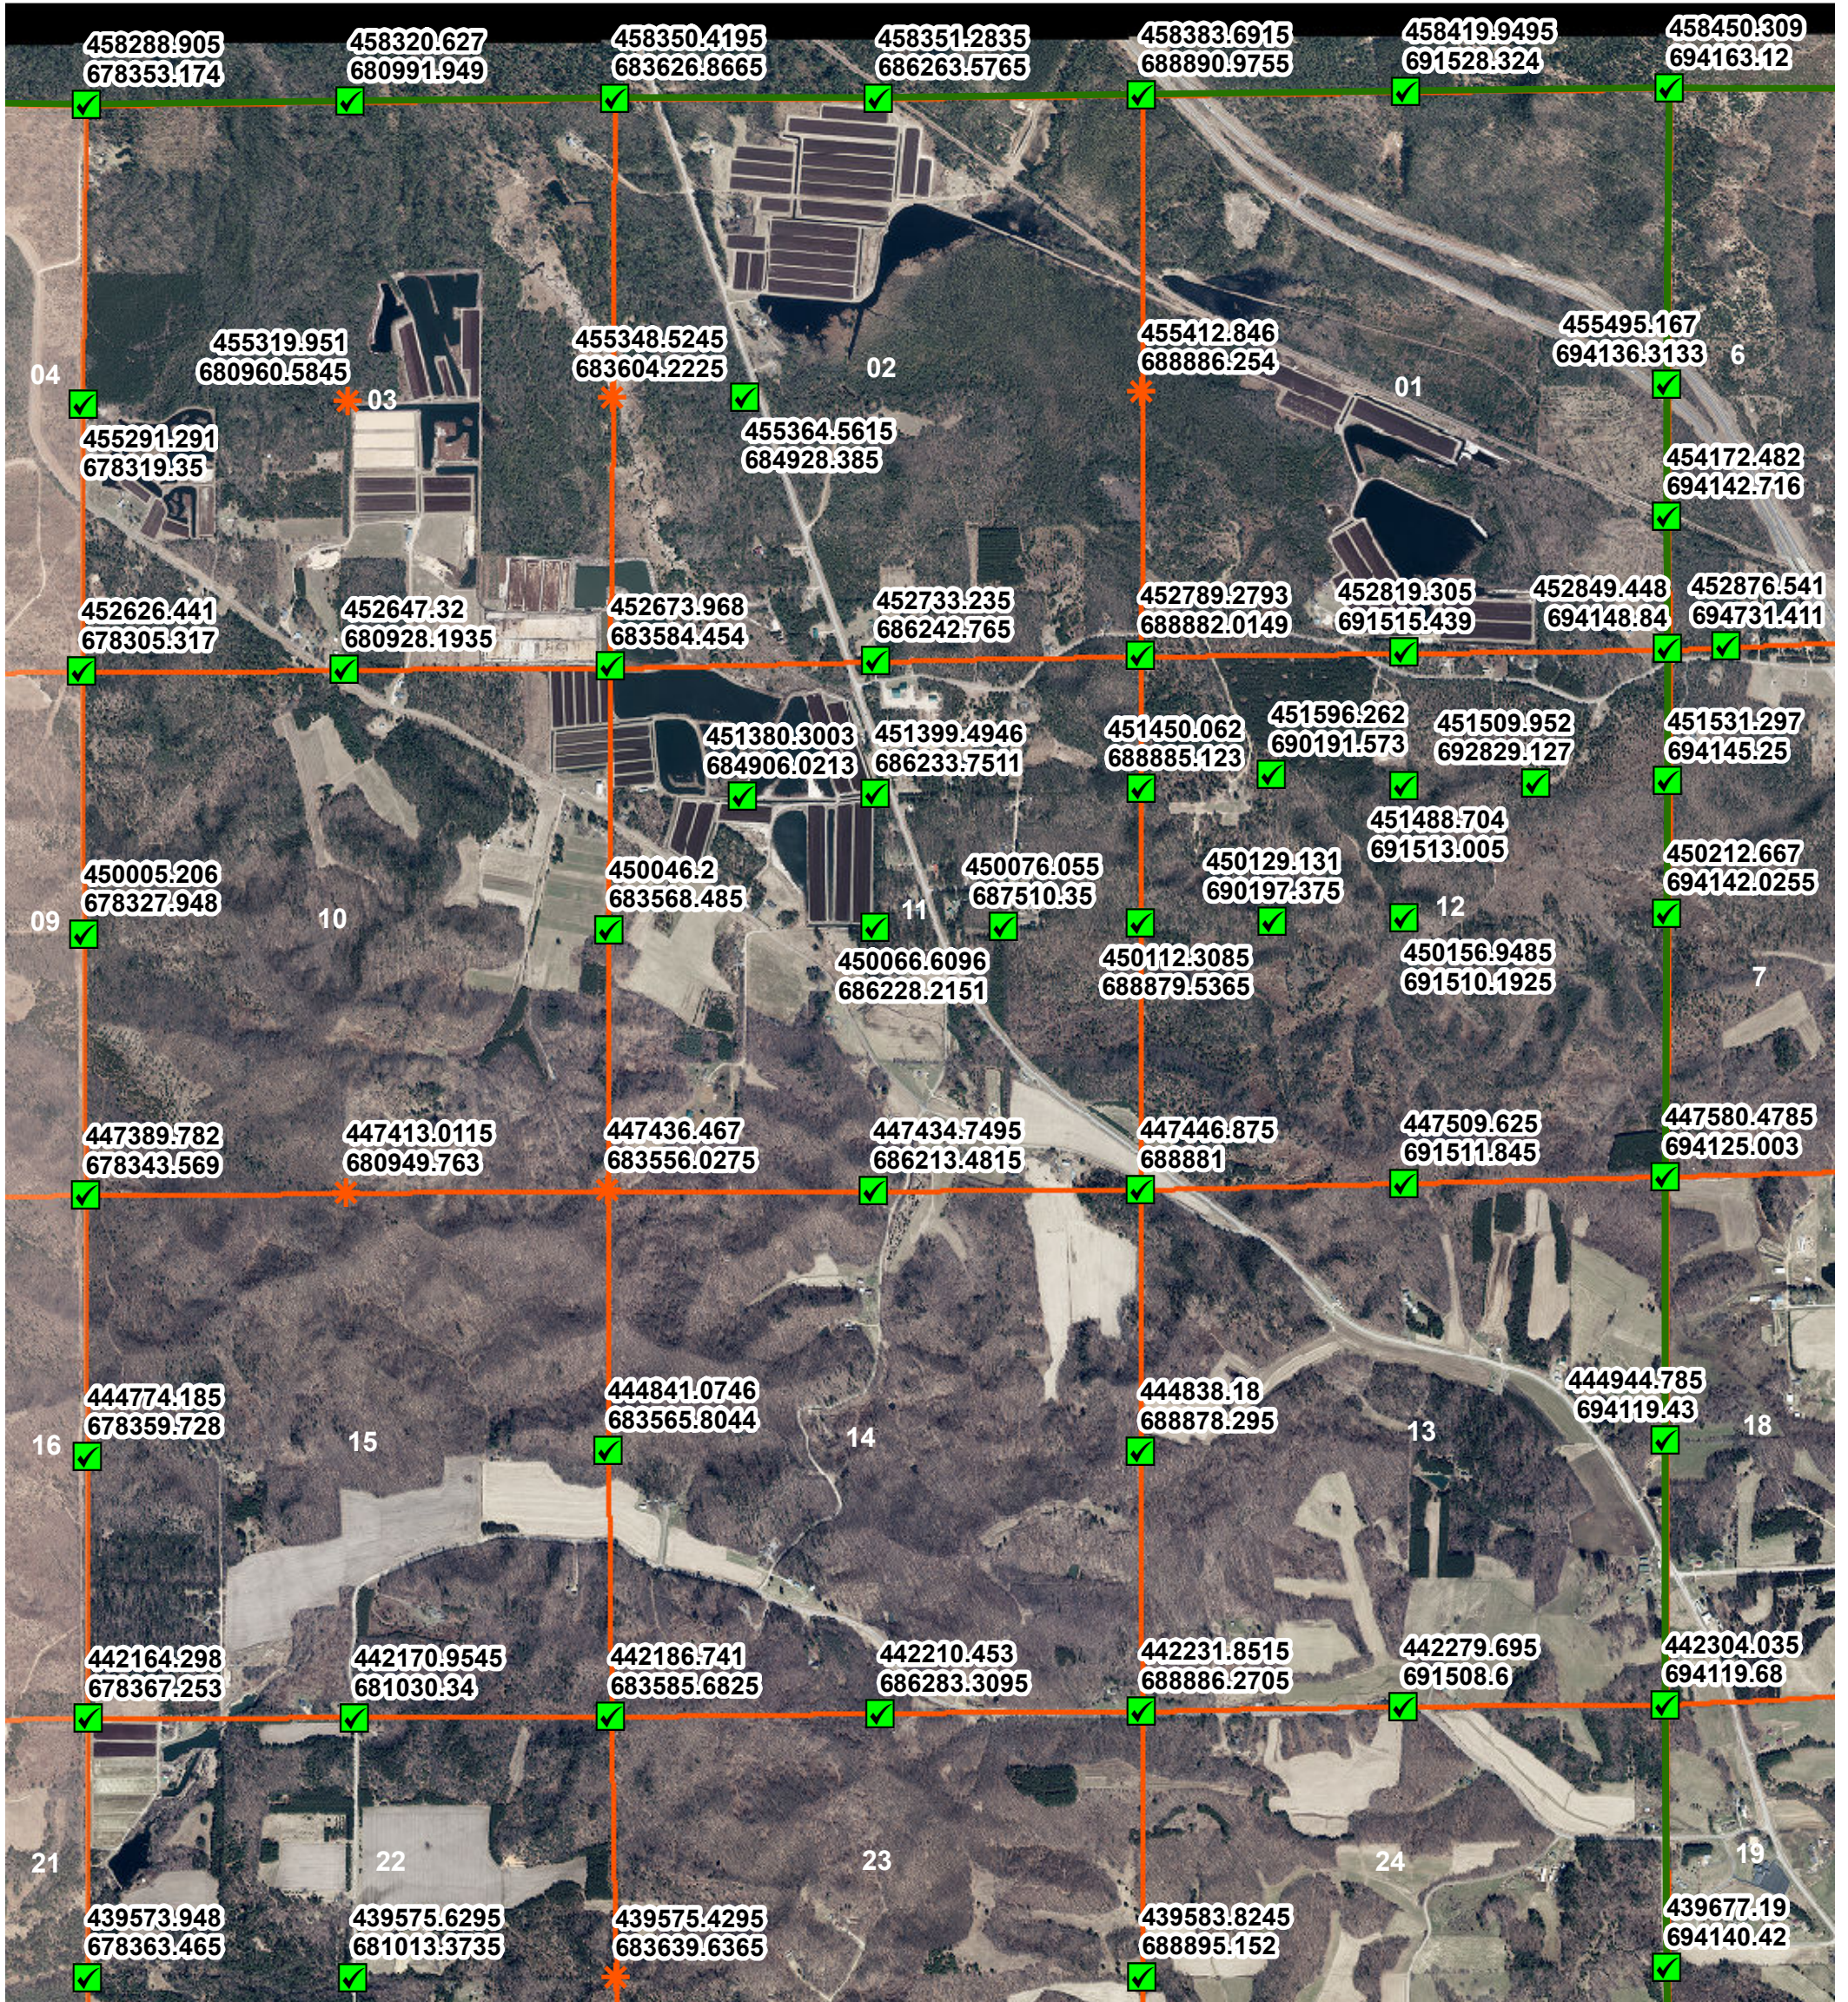

Legend

PLSS Coordinates

Coordinate Method

* Derived

✓ GPS

Fort McCoy Military Reservation

Date: 1/5/2022