


Grant PLSS Corner Coordinates - SW

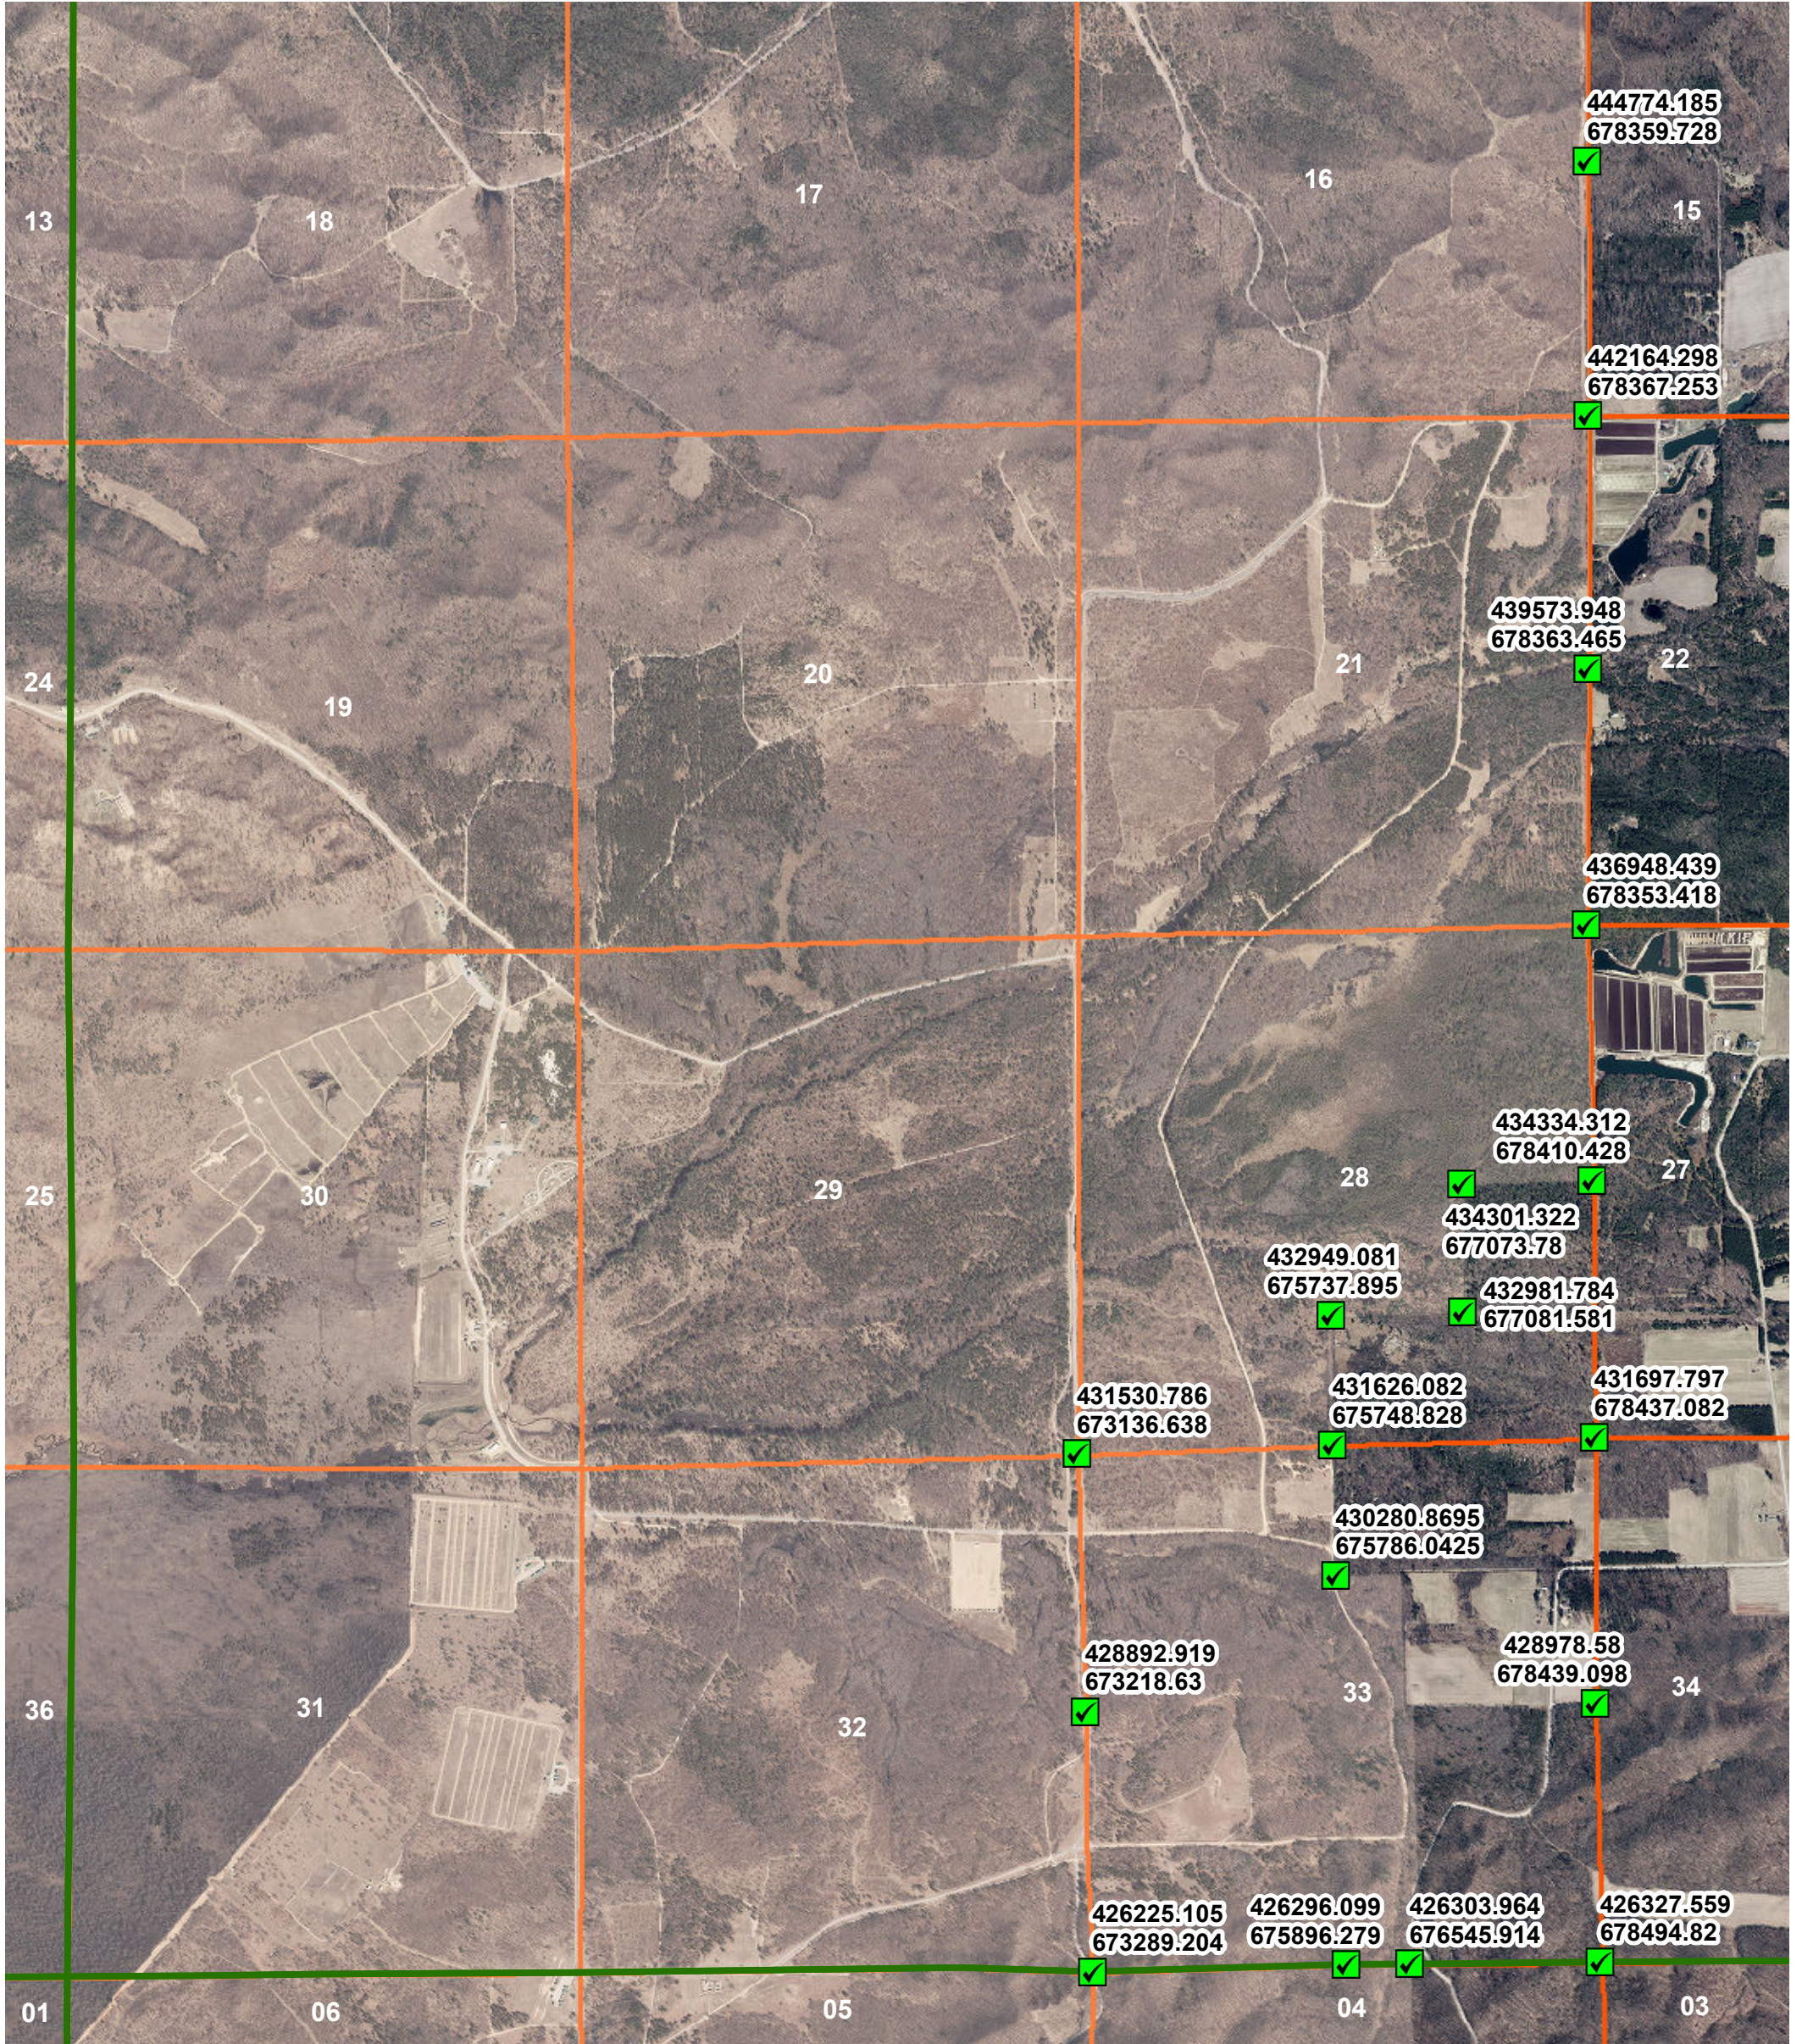

Legend

PLSS Coordinates

Coordinate Method

 GPS

 Fort McCoy Military Reservation

Date: 1/5/2022