Section 6 town 15-
Range 8 West

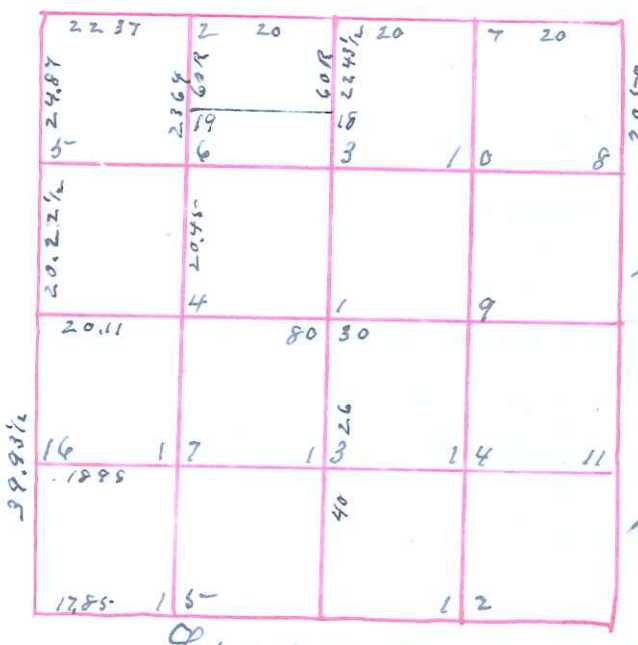


State of Wisconsin }
County of Monroe } ss
I Fred A Holden Surveyor in and for County and State aforesaid do Certify that I have surveyed and Subdivided Sections 6 Town 15- Range 8 West done in accordance with State Laws and the field notes of Original Govt Survey
March 31st April 1st 2nd 3rd & 10th ad 1903

Field Notes Made new true corners and

Original N W Sections Corner Fd 9 S87 E 19 Fd 6 N 22½ E 15-
" N E " " " Iron Sleigh Shoe at Corner
" S W " " " 4 Stumps & Stake Hole near the W'ly 10 S 6½ E 5-0
W'ly 5- S 23 E 10
Restab N¼ " " " Fd. 6 N 86 E 5-
Original E¼ " " " Iron Thimble South 19 links
Br'g S 67 W 44
" S¼ " " " Stump of other tree
Restab W¼ " " " Stake at Corner

Subdivision "
Fd 10 N 11 W 10½
# 1 W'ly 6 S 65½ W 36
" 2 Stake at Corner
" 3 " "
Br'g 4 S 30½ E 3
" 4 W'ly 12 N 6 E 24
" 6 W'ly 8 N 48 E 8
" 7 Stake at Corner
" 9 W'ly 5- N 4 E 13
W'ly 10 S 66½ W 13½
" 10 W'ly 7 N 5- E 4
Fd Pine 8 N 16 E 5-5-
" 13 Hickory 5- N 5-6 W 64½
" 14 Redo 7 N 12½ W 39
Redo 7 N 13 E 14
" 16 W'ly 5- S 33 E 5-½
" 17 Fd 16 S 4 E 183
W'ly 4 N 5-2 E 7
26 " 18 ~~Fd 4 bro~~ W'ly 4 S 5- W 5-
Fd 6 N 18 E 7½
27 " 19 W'ly 6 S 27 E 3½

Sworn Assistants
Chainmen
Charles Erickson
John Olson
Flagmen
John Erickson
Lewis "
Nels Olson
Axmen
Evan Anderson
Oscar Erickson

Witness My hand this 10th day of August ad 1903
Fred A Holden
Co Surveyor