Office Co Surveyor

Sec 1 – 19 – 4 W

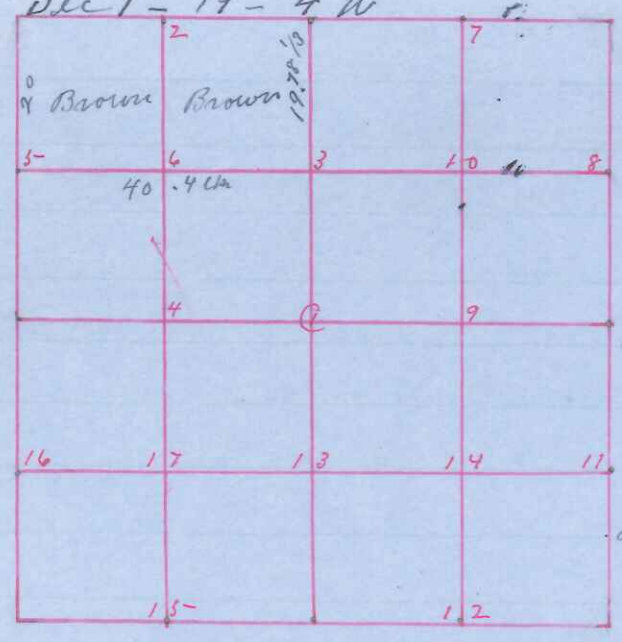

Survey Made Sept 2nd 1904
Sworn assistants
Chainmen
Charles Brown
Charles Adler
Flagman
Charles Stark
all random Stakes corrected
Lines run by fore & hind sights to

S E. Sec Corner Bo 6 S 26 E. 303
N W " original Tree Standing
N 1/4 Stone of old B Tree and old Stake
Made New Tree Br 0 24 S 72 W 88 1/2
W 1/4 original Tree Standing
C reestablished by Lane
#3 3/4 Pipe at corner
#5 " Pine 6 S 49 1/2 E 27
" 8 S 53 1/2 W 20 1/2 Kenyon 1886
#6 Stone 4 N 45 E 12
#13 Established by Lane

I hereby Certify that the above diagram and Field notes are Correct of the Survey of the N 1/2 of the N W 1/4 of Section 8 Township 19 North Range 4 West as surveyed by direction of Louis Brown dated this 13th day of September ad 1904

Fred A Holden
Co Surveyor