Sec 11 T 19 R 4 W

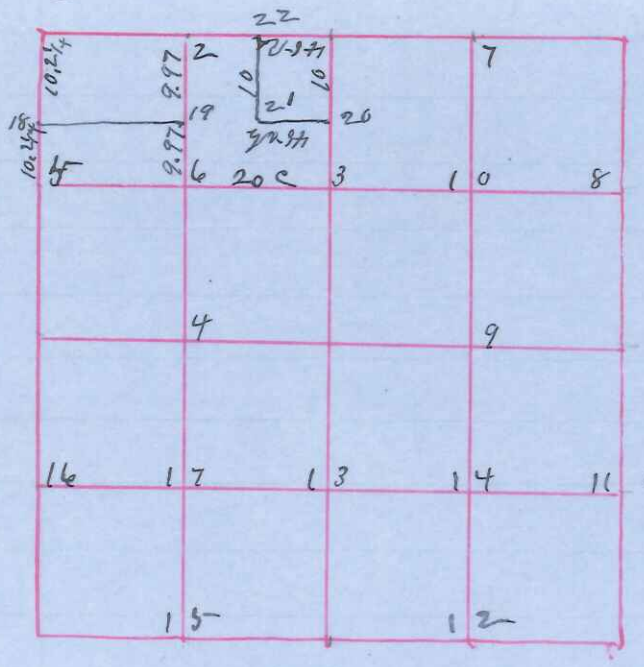

Survey Made Nov 8th 9th & 10th 1904
all lines run by fore and Back Sights all Random Stakes Corrected

Chainmen
Pat McCuddin
Seth. June

Flagmen
Pete Clemmonson
Joe Oneil

Field Notes

NE Sec Corner Re Established Set Stone at Corner
NW Original Stps butts B Trees Stake Pt dug out by Rock
SW "
SE "
N ¼ Re Established iron Pipe set Stone at corner
E " " " " " " " " " "
W Original Stone at corner
C buried Iron Wheel at corner Intersection of ¼ Lines
2 Stake
3 Iron Rake arm at corner
5- Stake
6 Stone + mk
8 Stake
10 "
20 Stone at corner
21 " " "
19 " " "
18 " " " Jo N 20 E 14½
22 " " "

I hereby Certify that the above diagram and Field Notes are Correct of the Partial Survey of Sections 11 Town 19 R 4 West as Surveyed by direction of Peter Clemmonson
Dated this 13th day of Feb 1905

Fred A Holden
