Sec 29 T 17 R 2 W

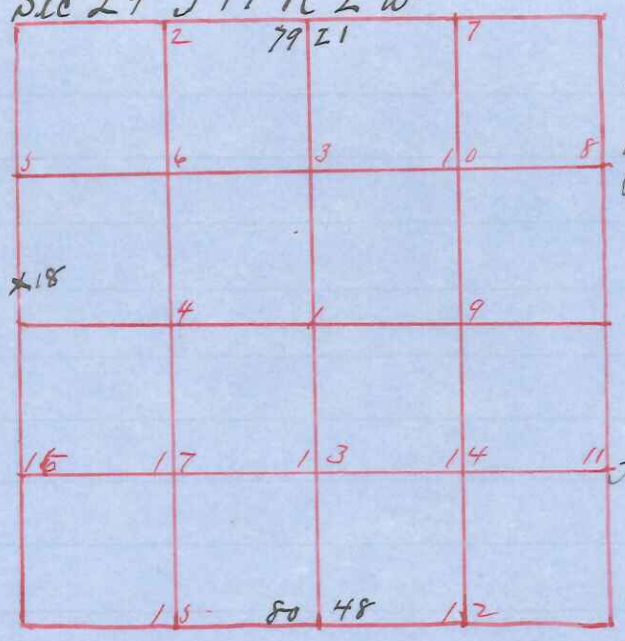

Survey made April 16th & 17th 1907
by direction of Thos Williams
Sworn assistants

Chainmen
Thos Williams
Steve Harrington

Flagmen
Will Williams
Dell Van Schaick
Will Bell John Walker

all Lines run by both fore and back sights all random Stakes corrected

Field notes

NE Sec Cor set for distance from West & South ~~1/2 ins pipe at Corner~~ No 85 14½ W 65½ new

NW " " " " " " " " 1/2 in Iron pipe at corner

SW " " Original Corner

SE " " Re established No 18 N 44 E 14 1½ Pipe at corner

N 1/4 " " " " in Line to 7 S 70 E 3 new

S 1/4 " " " " Hick 14 N 13½ W 20½ new

E 1/4 " " " " Stake

W 1/4 " " " " "

#2 To 12 N 17½ E 86-½ 1½ in pipe at corner

#3 Stake

#4 Bo 14 N 40½ & 42

#5 To 8 S 48½ E ~~3 1/4~~ 21

#6 To 6 No 40 E 3 1/4 1½ pipe at corner

#12 Bo 14 N 49½ W 21

#16 Bo 12 N 5-3 W 13 1½ in pipe at corner

#17 Bo 10 N 47½ W 18¾ " " " "

#18 26 Stake

Recorded this 24th day of October 1908
Fred A Holden
Co Surveyor