36 T 15 R 15 1 E

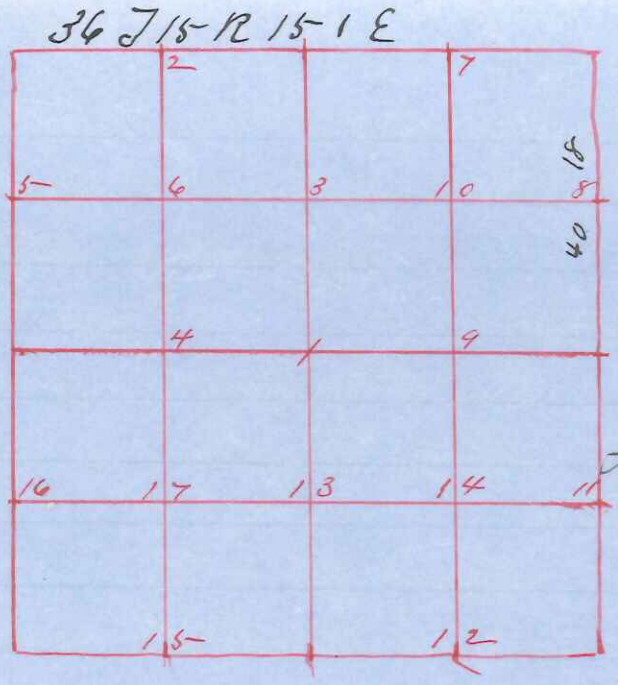

Survy Made May 1907
by direction of J & Buchert
Chainmen
J & Buchert
Chas Granger
Flagmen L Mack
Rudolph Klumph
Run the East Line from NE Sec Cor
to 1/4 part on East side 40 chains 18 Lks
Made new bearing for 1/4 part

Found
NE Sec Cor
E 1/4 " "

Field notes
Original Cor
" remains of old bearings Rich 6 N 48 W 41
Mple 6 N 49½ E 52½ new

Recorded June 15th 1907
Fred A Holden
Co Surveyor