
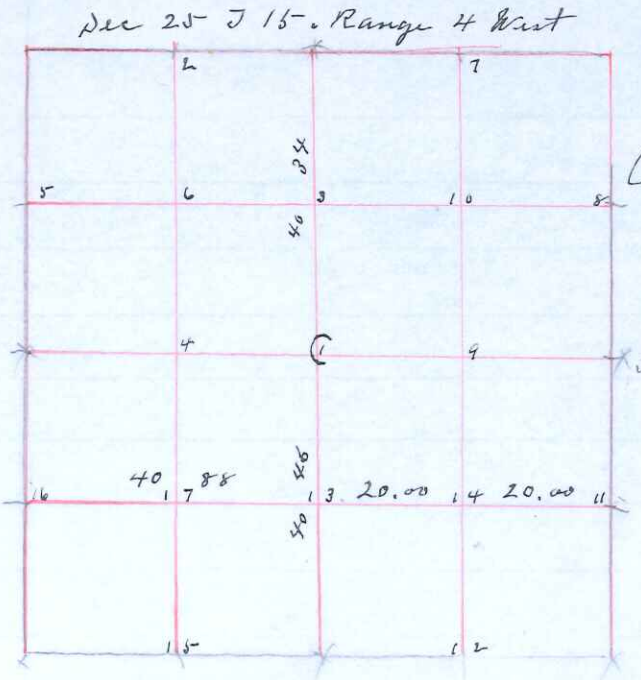

Survey made Dec 13 + 14 1909

Town corners

Chainmen

Luis Ericksson

Lars Olson

Flagman

E Peterson

C Peterson

N E Sec Cor not touched

N W " " " Original by Roots old B Tree and old Stk Pt
Now to 18 S 45-½ W 5-7 Set 1 in iron

S W " " " Original

S E " " "

N ¼ " " "

S ¼ " " "

E ¼ " " Re established in Iron

W ¼ " " Original Set Iron pipe at Corner

#11 set Gal Iron angle Iron at Corner

#13 " 1½ in pipe at Corner

#14 " " " " " "

I hereby Certify that the above diagram and field notes are Correct of the partial Survey of Sec 25 Town 15 N Range 4 W as surveyed by direction of Lars Olson and E Peterson

Dated this 15th day of December 1809

Fred A Holden

Surveyor Monroe Co Wis