Sec 23 Town 19 Range 4 E

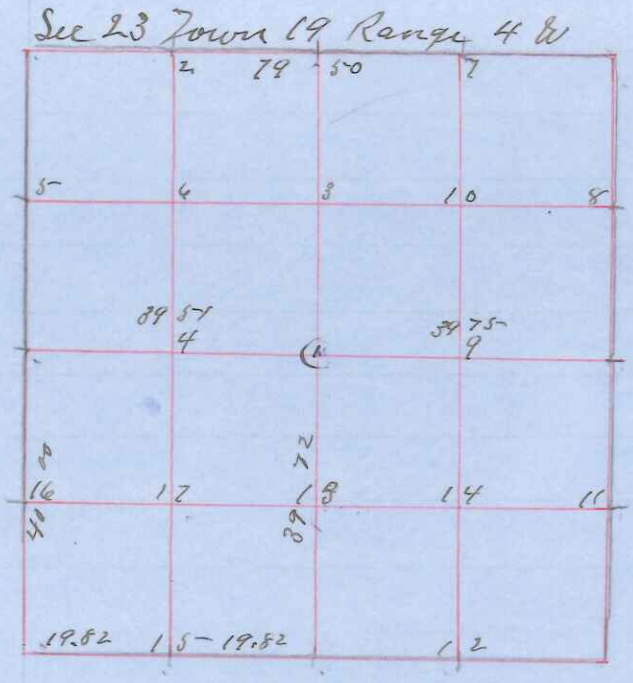

Survey Made April 4.6 & 7 1910

Sworn assistants

Seth Jane } Chainmen

Lester Walker }

Paul Christensen } Flagmen

Peter Bayson }

Paul " }

NE. Sec Cor — Bro 12 S 5-5 E 323 Original

N W " " — Re-established as per rule

S W " " — Bro Stke 6 S 41 W 19 Original (Stake

" Roots N 18½ E 19 Stk hollow Set Stone in Side

N 1/4 " " — Re-established in line

Bro Stk S 81½ W 17

S 1/4 " " — Bro 7 N 27 E 99 old Stk & pits Set Stone at Corner

E 1/4 " " — Bro 7 S 25 W 37 Original (other tree gone

W 1/4 " " — Remains both B Trees & old Stk pt

Fd 12 N 41 E 60 Trees

" 12 S 44¼ E 5-5 " Set Stone

C1 Set Stone

18 Stake

18- Set drive Well Point

17 Stake

I hereby Certify that the above diagram and field notes are Correct of the partial Survey of Section 23 Town 19 Range 4 East as Surveyed by direction of Peter Bayson Dated this 8th day of April 1910

Fred A Holden

Surveyor Monroe Co Wis