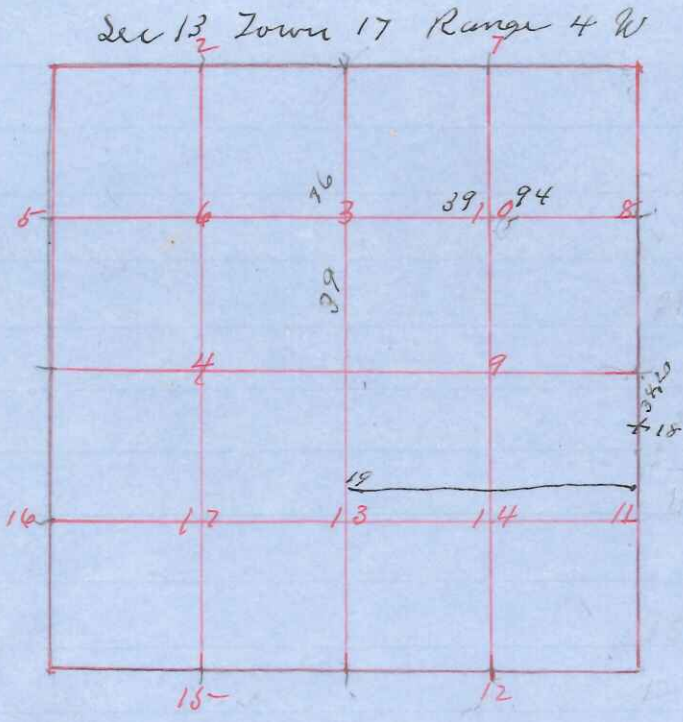

Survy June 1910

N E Sec Stk pt in Original Mound
Set Iron pipe
S E " Cor original Corner
N 1/4 " " " "
S 1/4 " " Re Established "
E 1/4 " " Chained Bet Elds S N 79½ W 176
Re Established in Iron
(Center) Center Intersection Rusk & Mont St
8 Bro 24 North 187
10 Iron Stake
18 Jo 12 N 44 W 84½ ½ is Iron pipe

I Hereby Certify that the above diagram and field note are Correct of the Partial Survy of Sec 13 Town 17 N Range 4 W as Surveyed by direction of the State Board of Control

Fred A Holden

