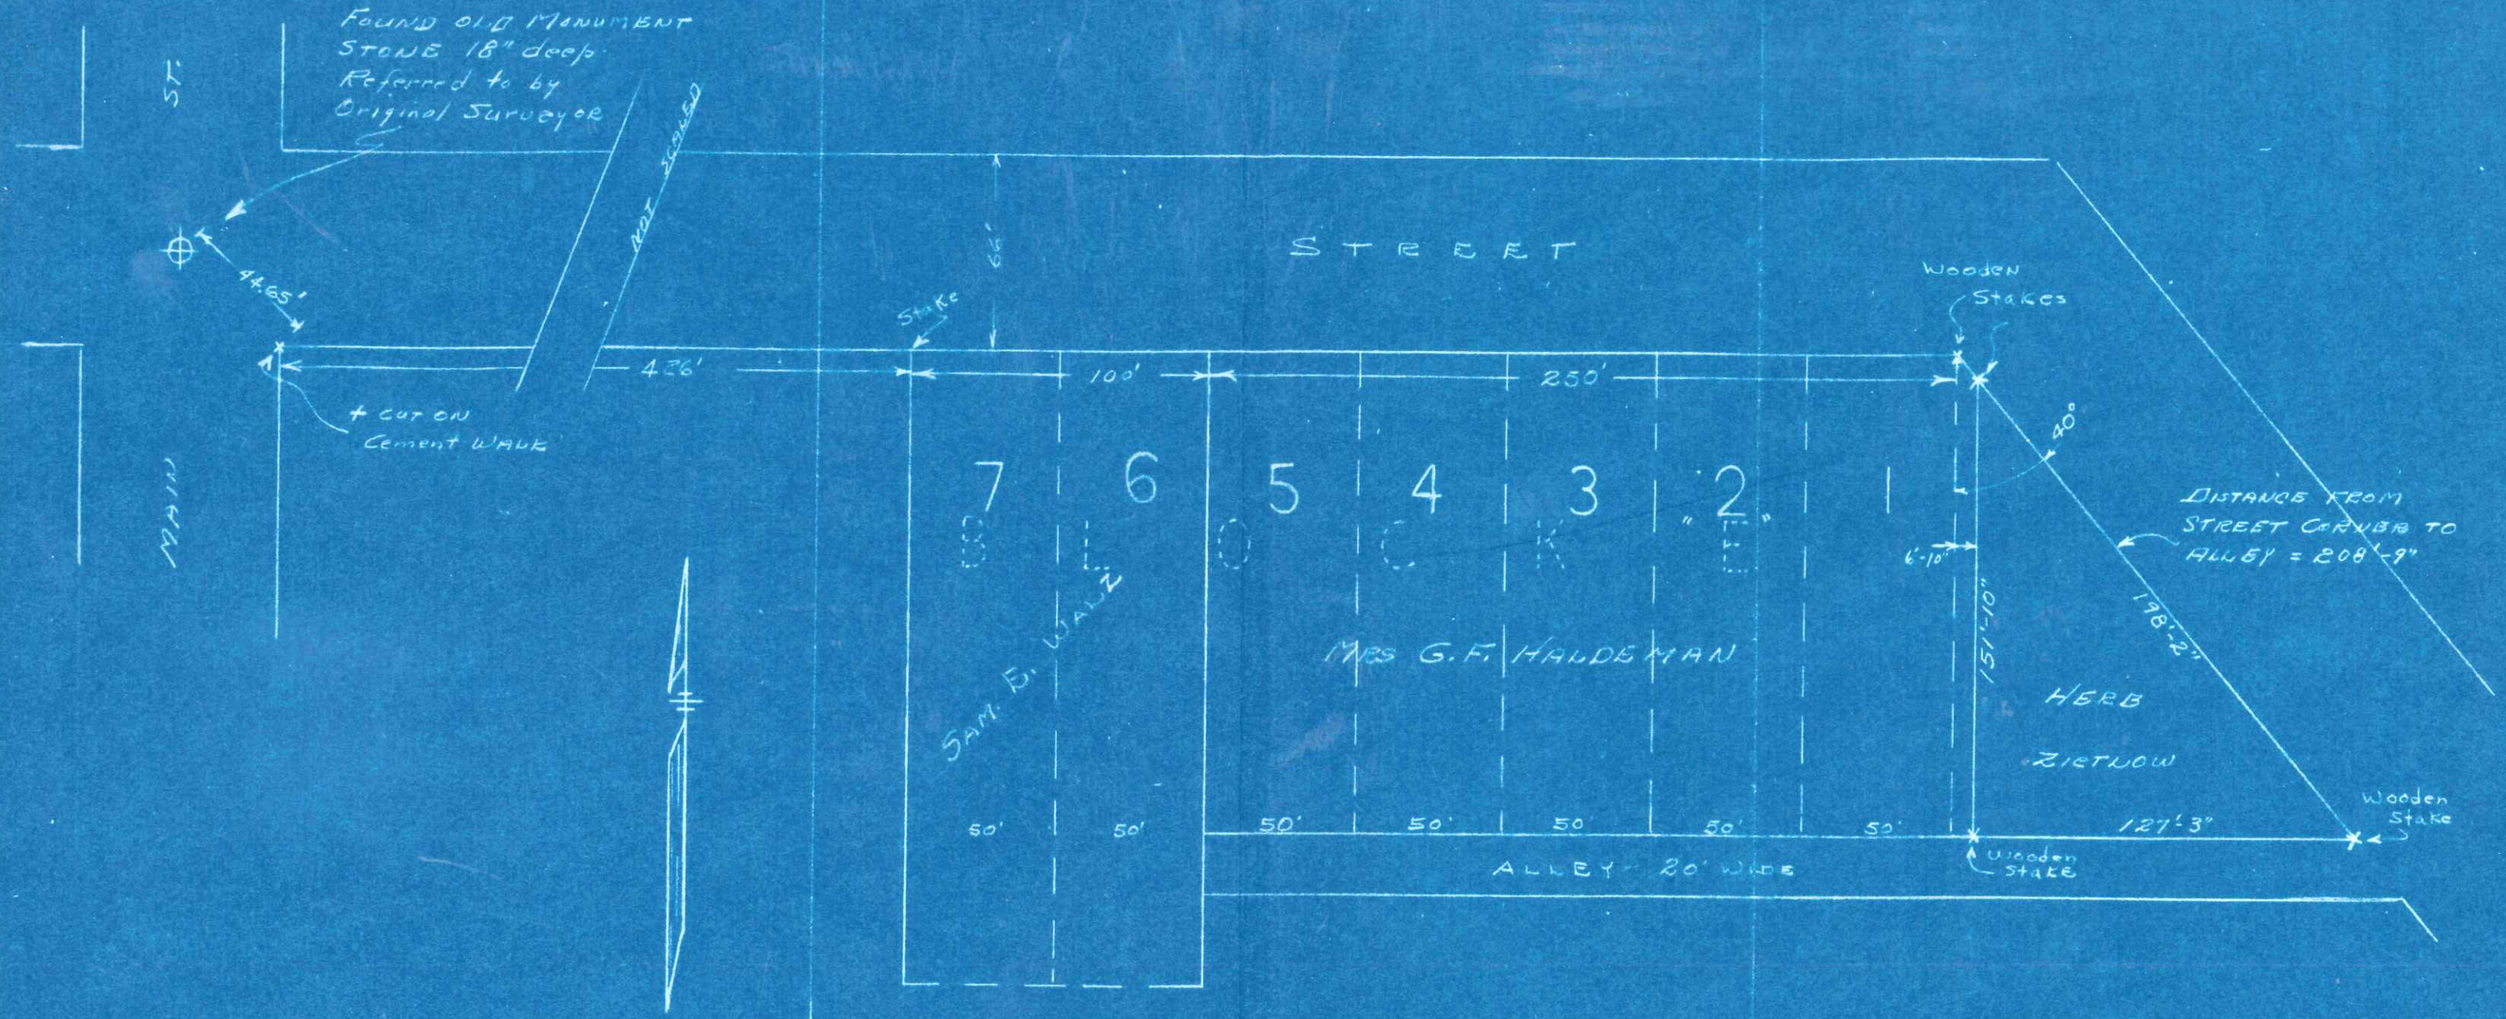

PART OF HALDEMAN'S FIRST ADD.
VILLAGE OF NORWALK

Survey Made By O.O. Bergman
8-22-45 Scale 1" = 50'