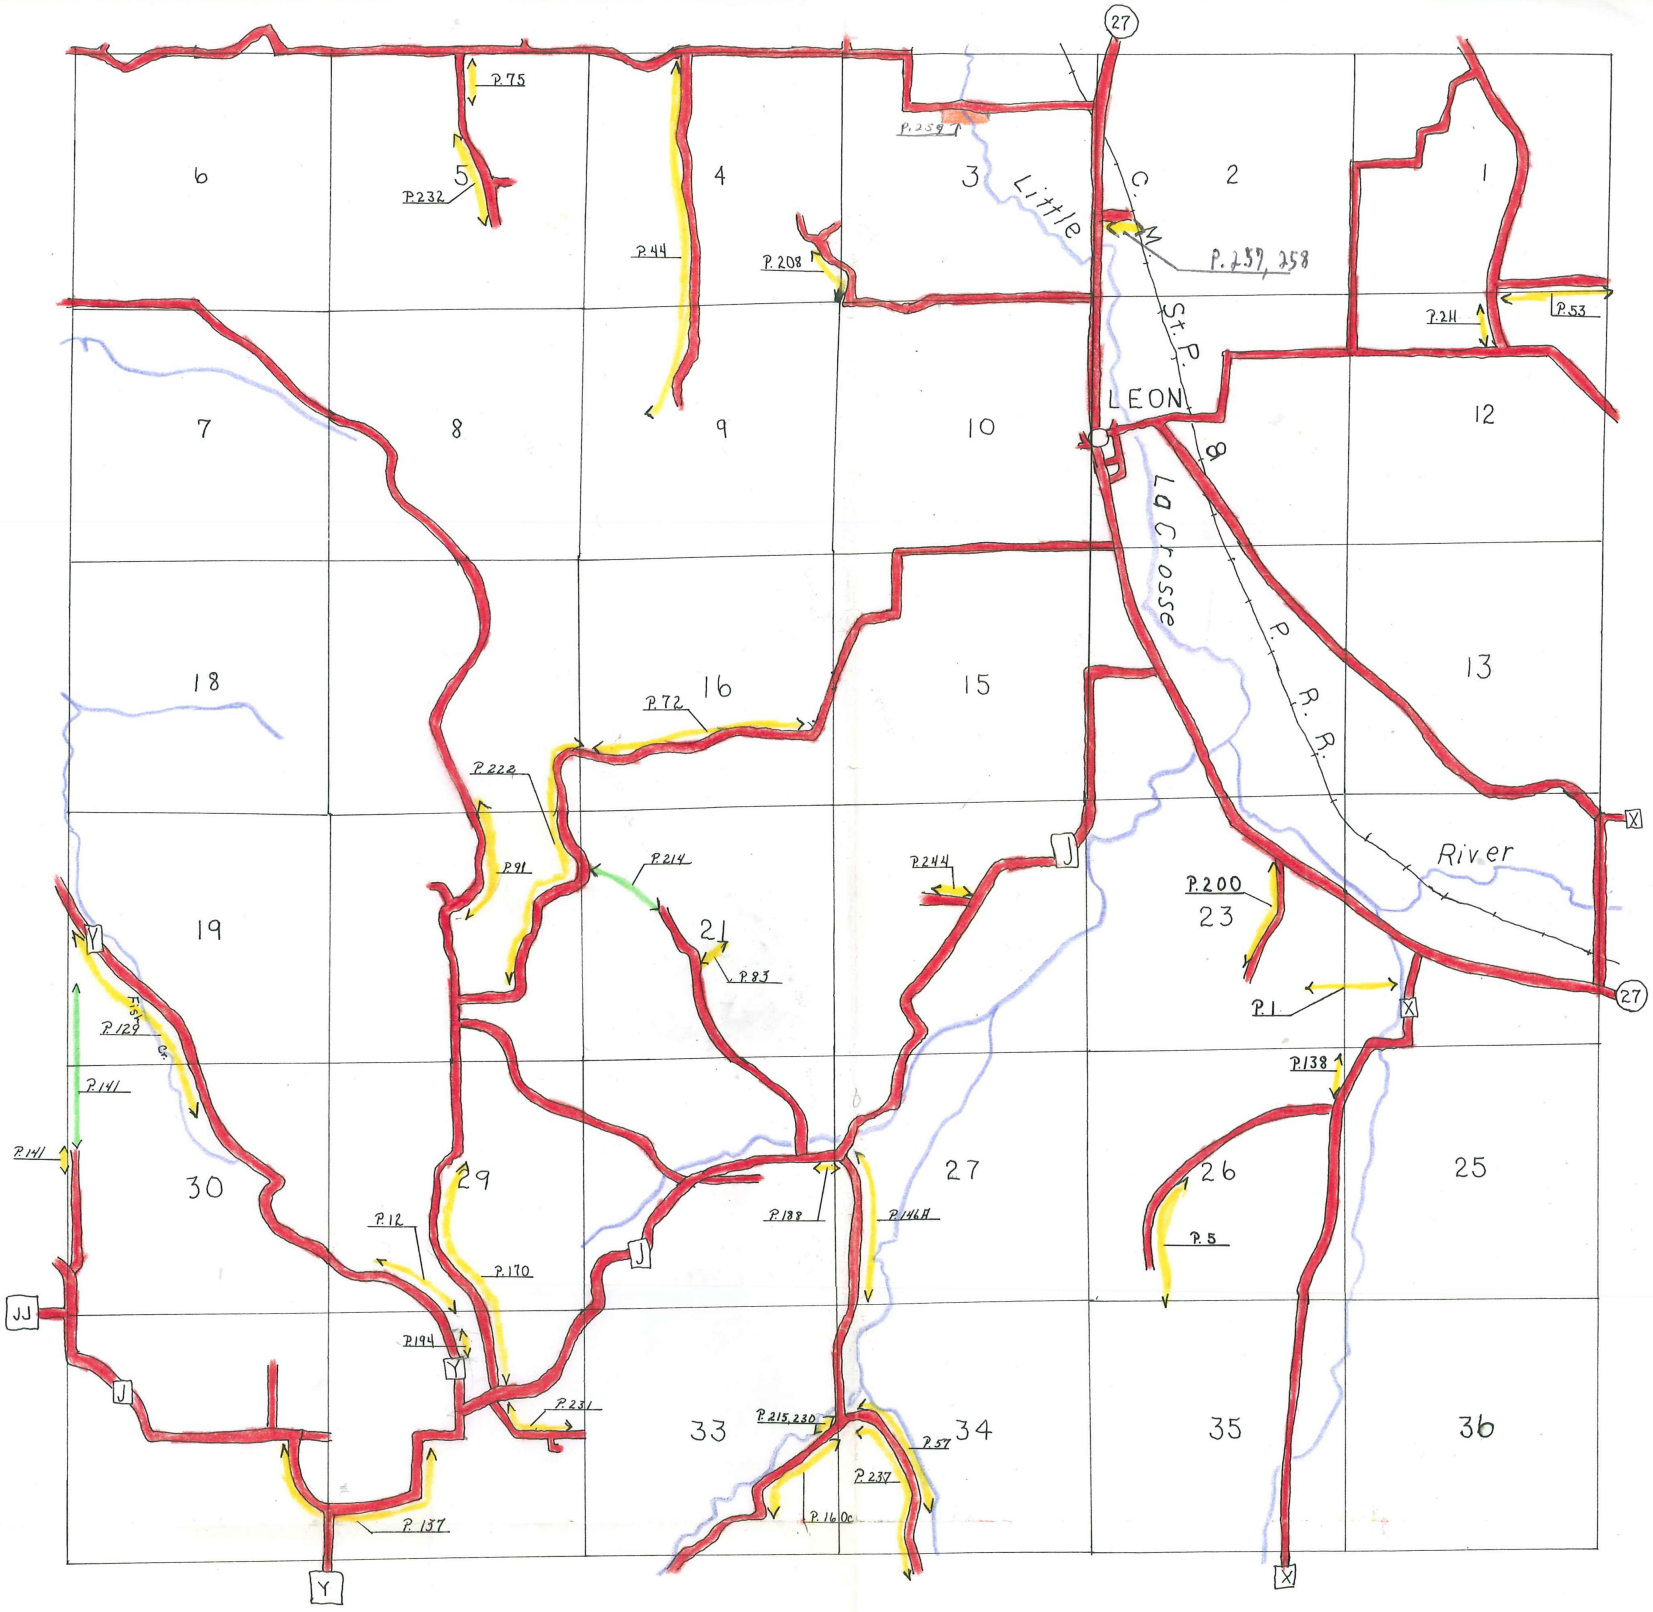

Township of Leon

T. 16 N - R. 4 W.

0 1.0 Mile

Roads Present

Roads Layed Out

Roads Discontinued