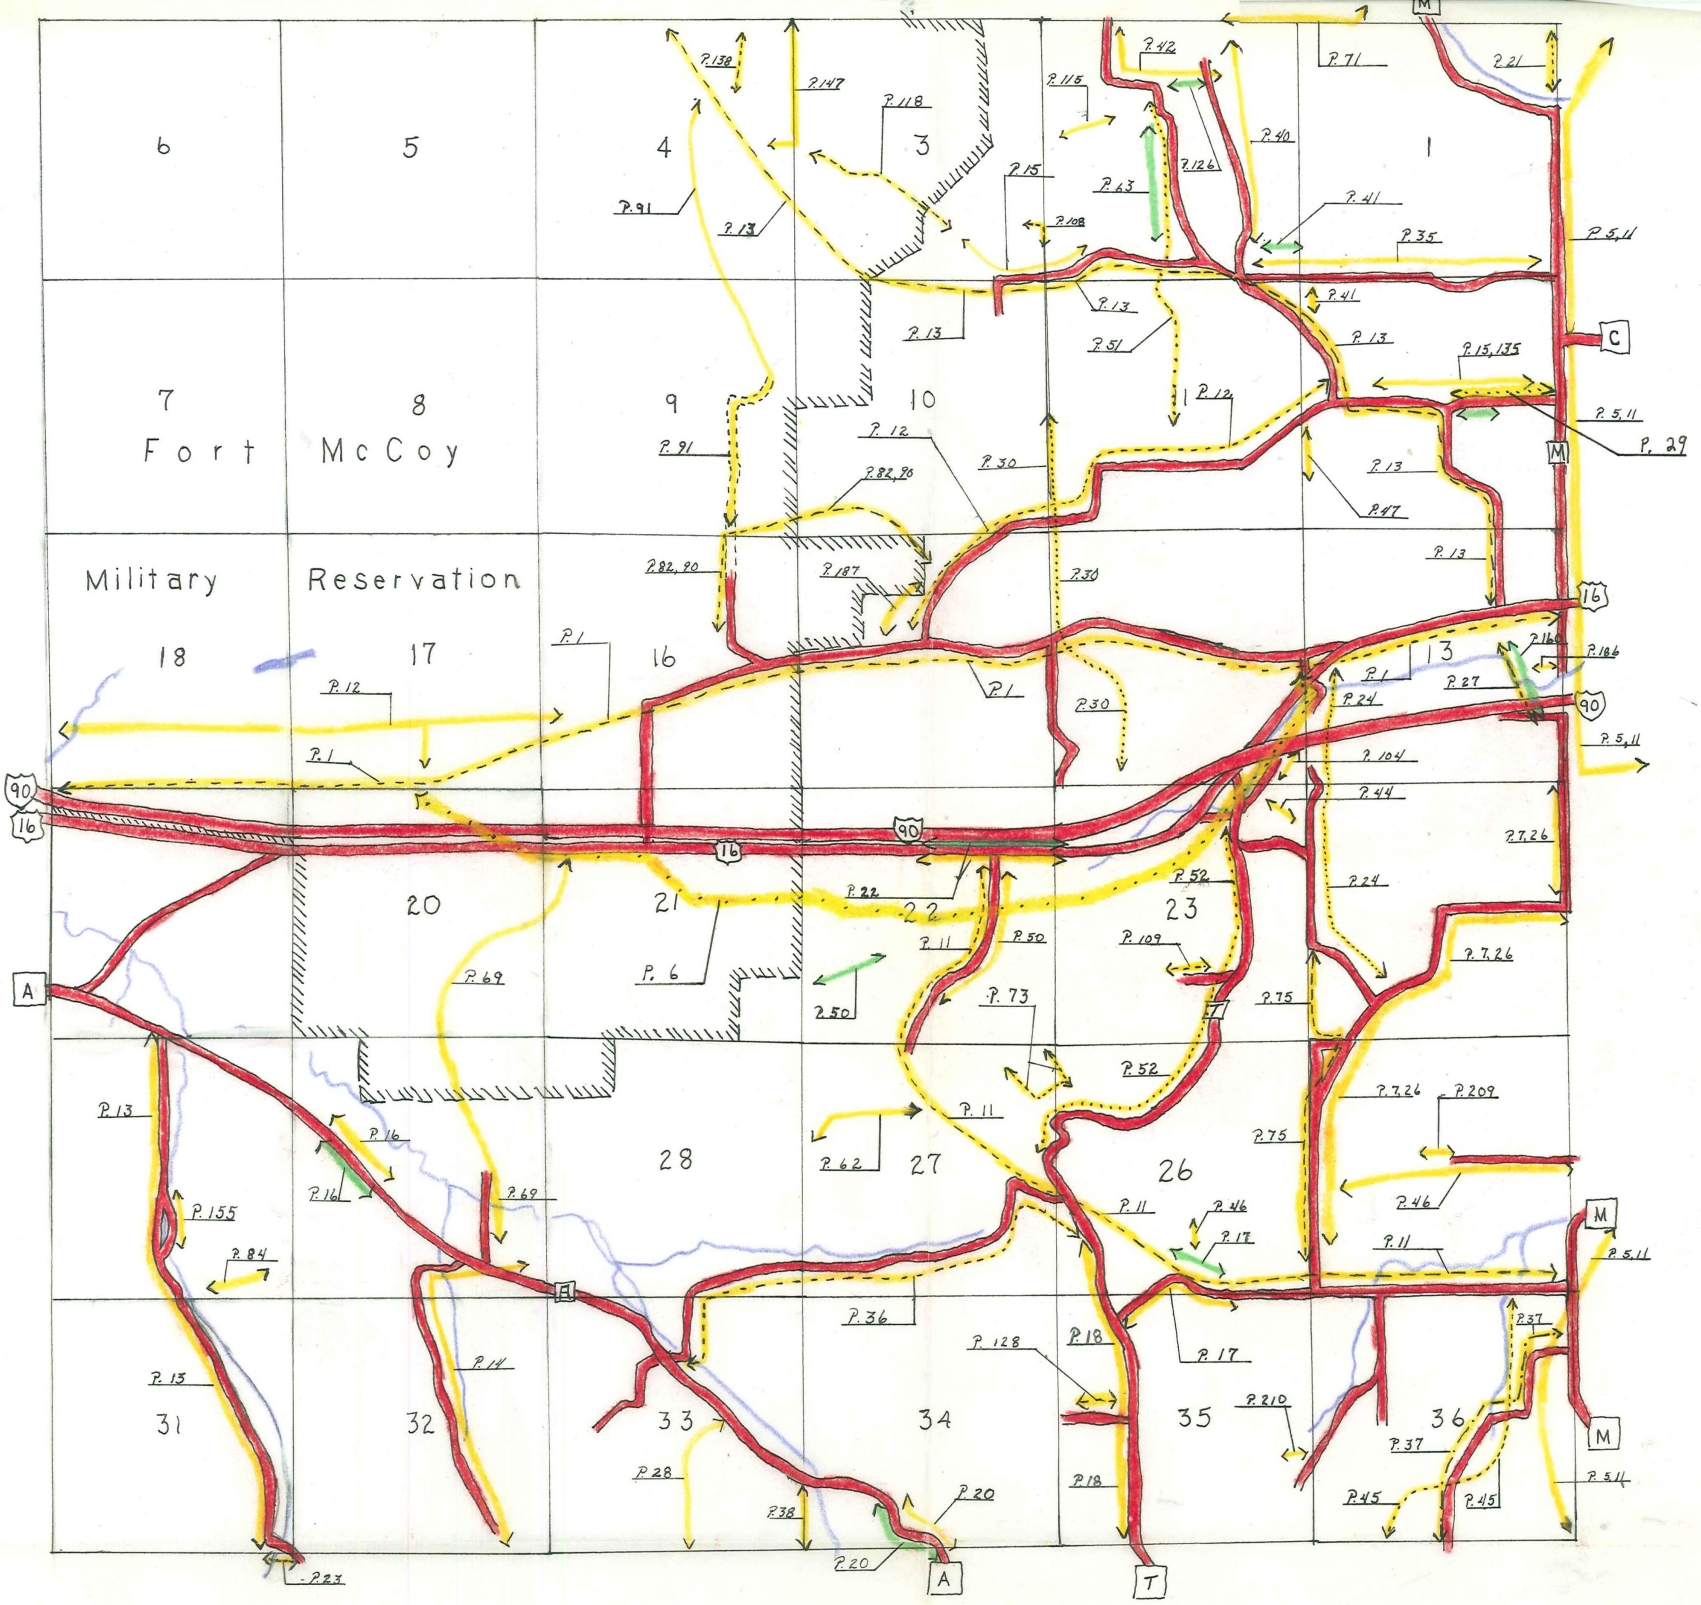

Township of Adrian
T. 17 N R. 2W

Present Roads
Roads Layed Out
Roads Discontinued

0 1.0 Mile
Scale: 2 inches equals 1 mile

N