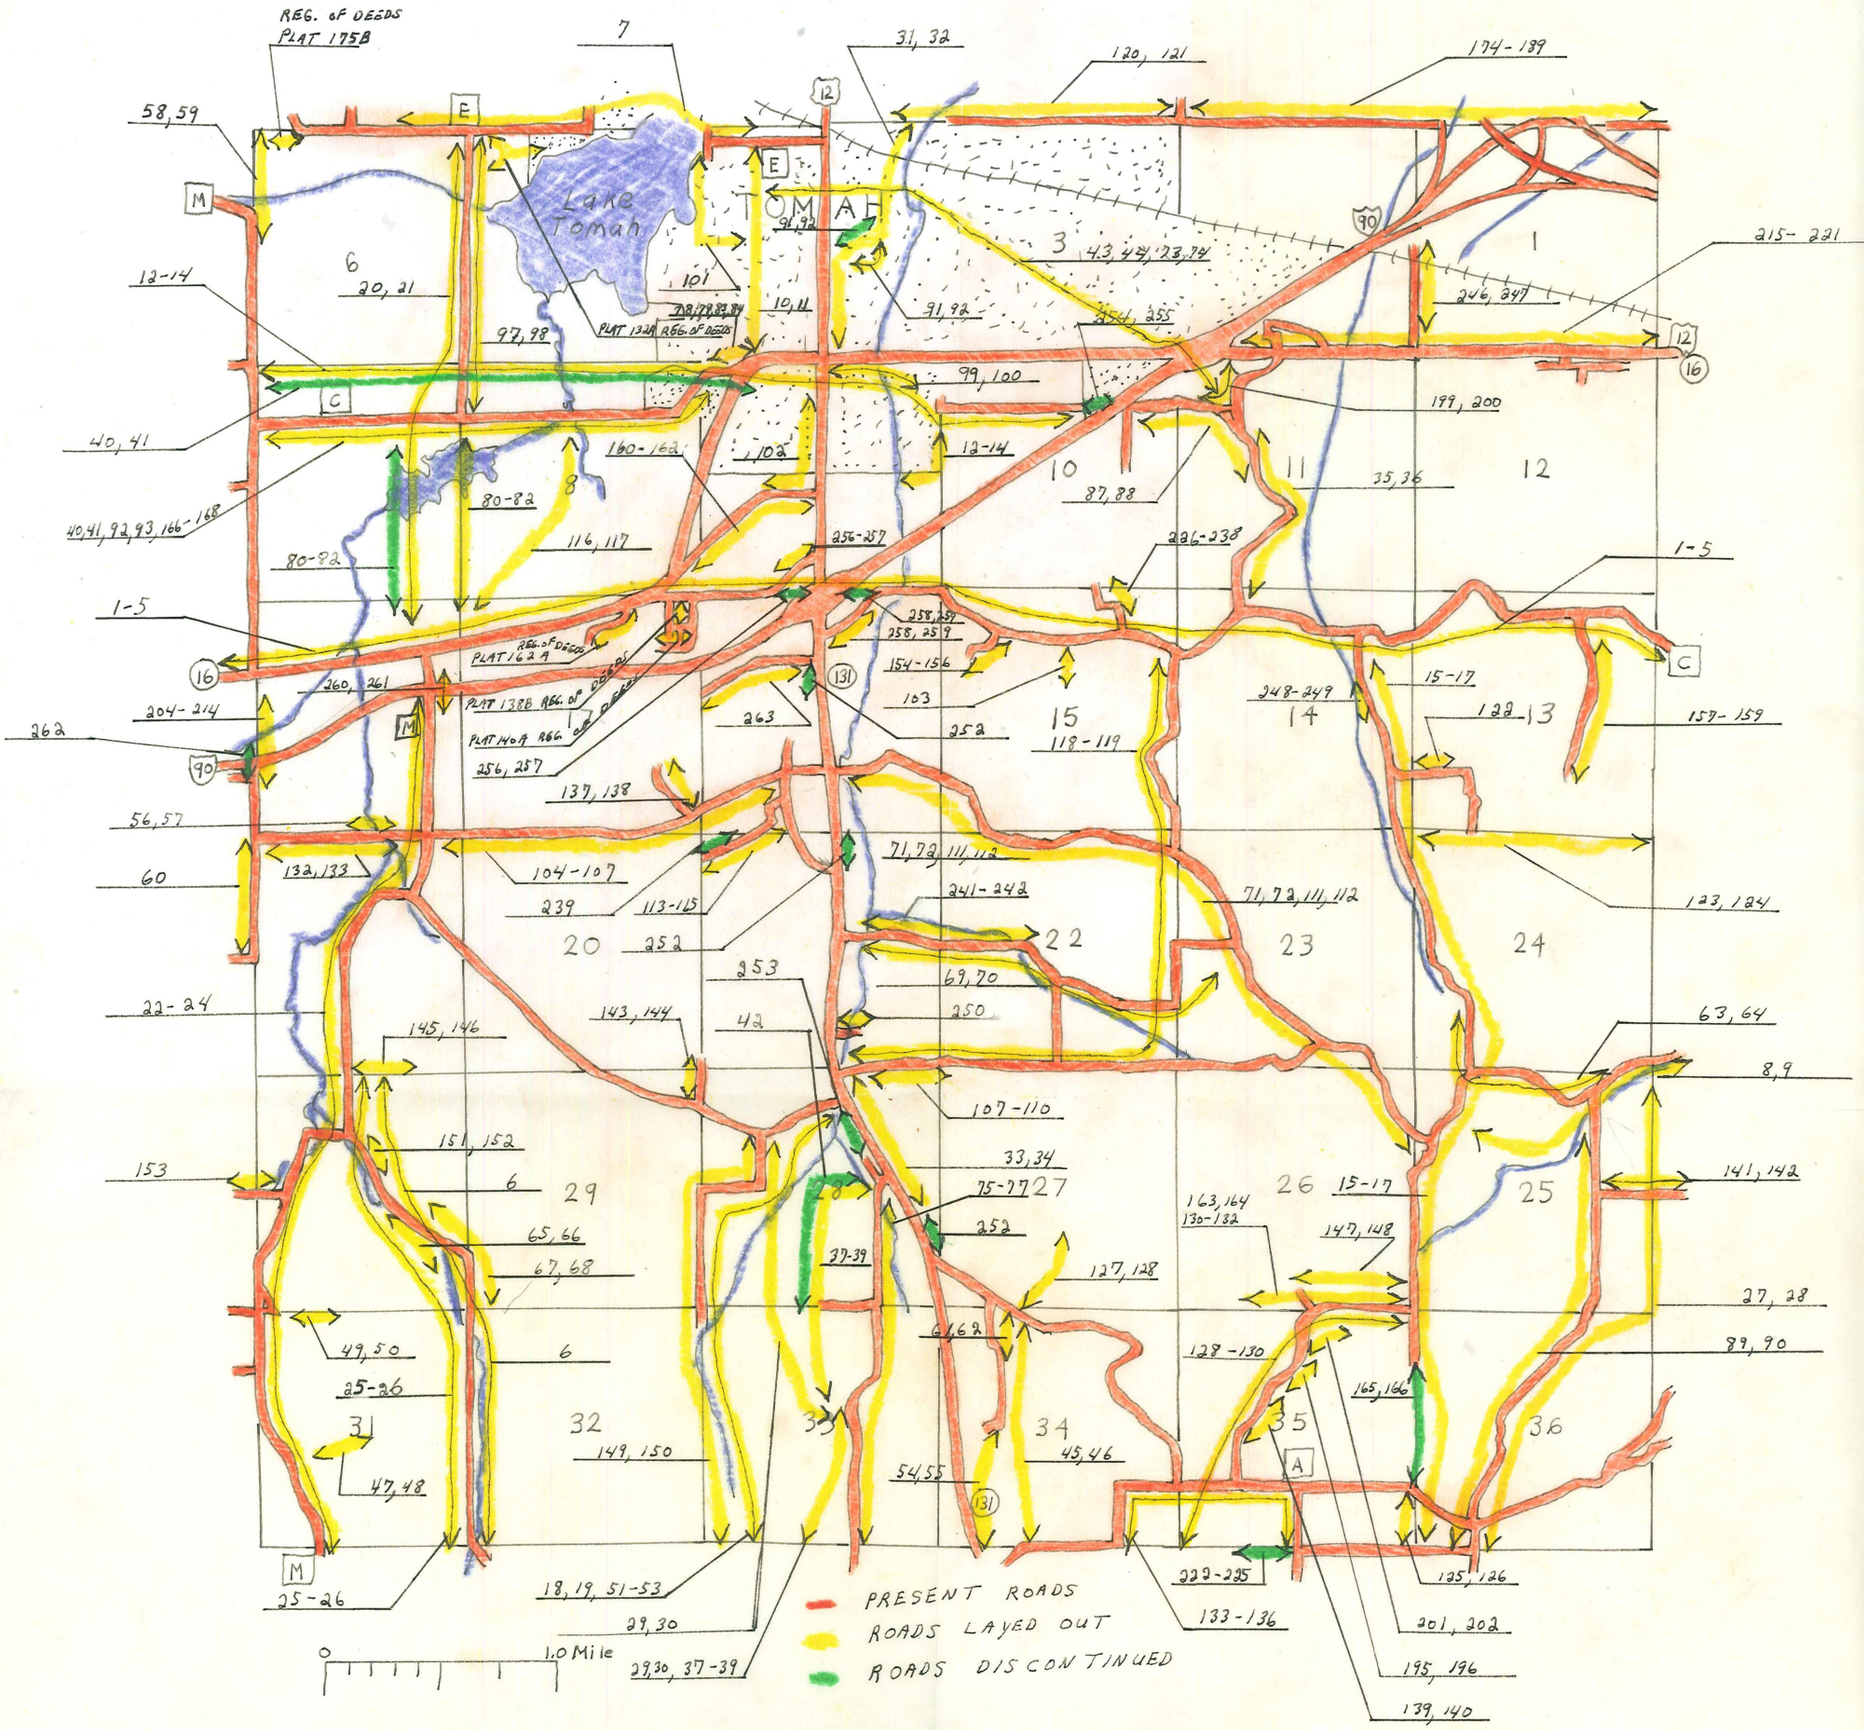TOWNSHIP OF TOMAH