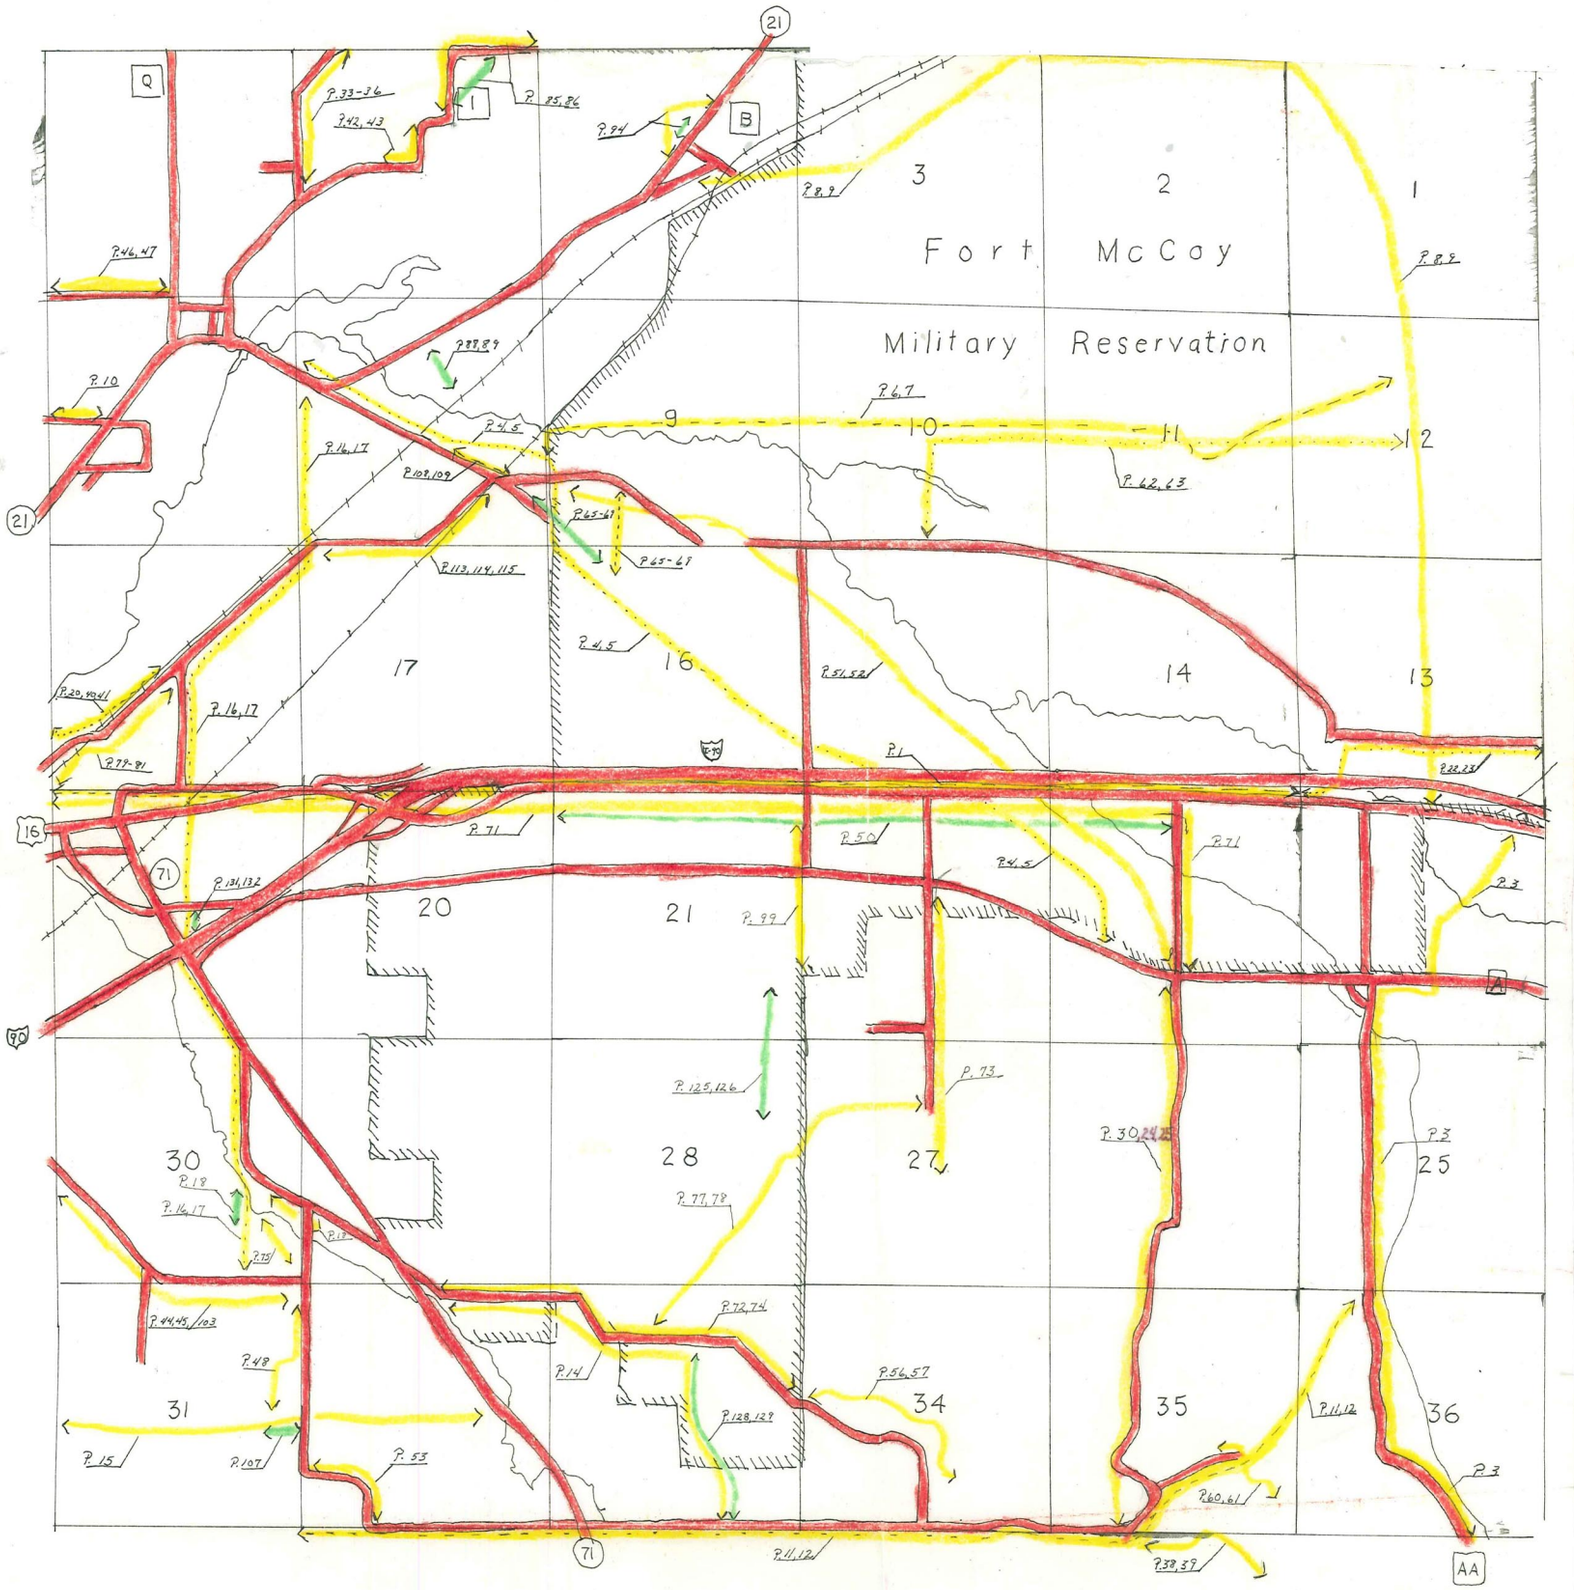

Township of Angelo T17N R3W

Scale 2 inches = 1 mile

0 .25 .5 1.0

1977

N

Present Roads

Roads layed out

Roads discontinued

TELEDYNE POST 18AE-205—24X36