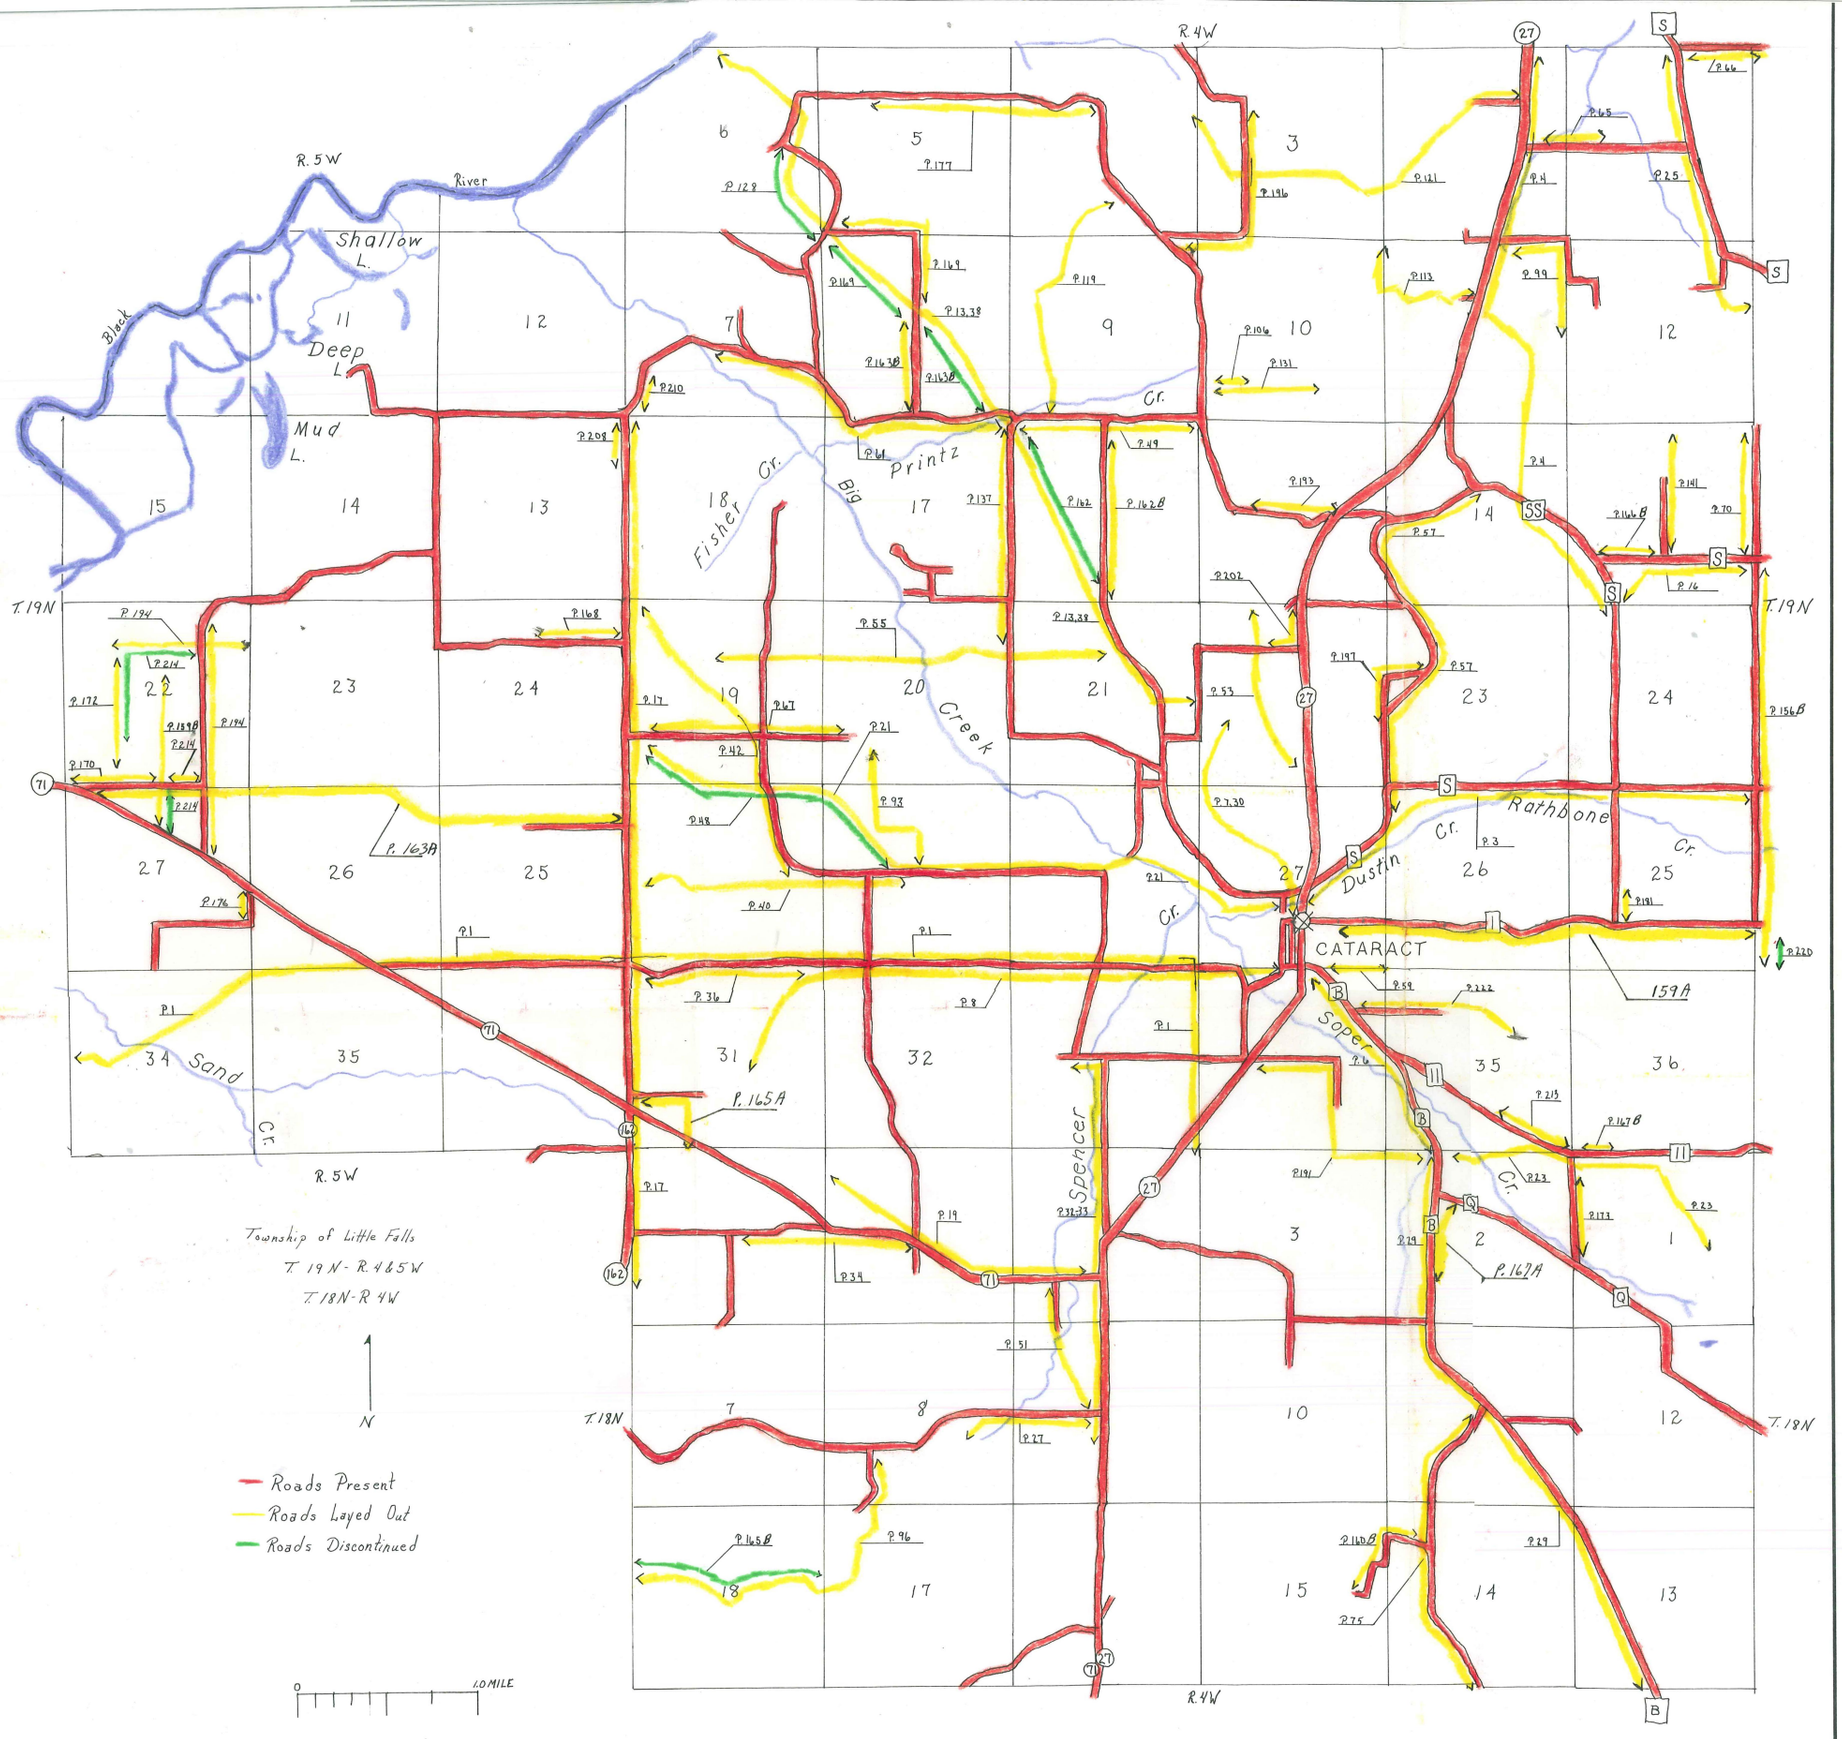
R.5W
R.4W
T.19N
T.18N
Black River
Shallow L.
Deep L.
Mud L.
Fisher Cr.
Big Printz Creek
Sand Cr.
Spencer Cr.
Dustin Cr.
Rathbone Cr.
Soper Cr.
CATARACT
Township of Little Falls
T 19N - R 4&5W
T 18N - R 4W
N
Roads Present
Roads Layed Out
Roads Discontinued
0
1.0 MILE